

SECTION

RECEIVED

1998 DEC 30 AM 10:19

LAND CORNER RECORDATION CERTIFICATE
Filing Requirement of Act 74, Mich. P.A. 1970

Linda Doughmiller
WEXFORD COUNTY, MI
REGISTER OF DEEDS

For corners in

WEXFORD
(County)

Located In:

Corner Code #

1. Public Land Survey

T 22N R 12W

M-9

2. Property Controlling
in Section S___
3. Miscellaneous S___
Property in Sec. S___

Common to:

A-9 T22N, R11W

4. Lot No. _____, Recorded Plat _____
5. Private Claims _____

Register of Deeds Stamp & File Number

I, CRAIG J. PULLEN, PS, in a field survey on NOVEMBER 24, 1998, do hereby state that under requirements of P.A. 74, Michigan P.A. of 1970, the corner points mentioned in lines 1 and 2 above were in conformance with regulations and rules therefore as required in the current manual of survey instructions of the United States Department of the Interior, Bureau of Land Management or by a decree of a Court of Law and/or that the corner points mentioned in lines 3, 4 and 5 above were in conformance with the rules of the Michigan Board of Land Surveyors or by a Decree of a Court of Law; established, re-established, monumented, recovered, found as expressed below:

NOTE: Not more than 2 corners, all in the same town and range, may be recorded on this certificate.

	A	B	C	D	E	F	G	H	I	J	K	L	M
1													
2		6		5		4		3		2		1	
3													
4		7		8		9		10		11		12	
5													
6		18		17		16		15		14		13	
7													
8		19		20		21		22		23		24	
9													
10		30		29		28		27		26		25	
11													
12		31		32		33		34		35		36	
13													

A. Description of original monument and accessories and/or subsequent restoration:


M-9 1838 G.L.O. SURVEY BY J. BRINK WOOD POST BEECH 9 S31 1/2W 22 BEECH 9 N18W 35

B. Description of corner evidence found and/or method applied in restoring or reestablishing corner:

M-9 FOUND CABIN SPIKE 1.5' NORTH OF EAST-WEST TWO-TRACK, IN CENTERLINE OF FAINT NORTH-SOUTH ROAD GRADE, AND 47' WEST & 26' NORTH OF NW CORNER OF PINE PLANTATION. ALSO FOUND USFS WITNESS TAG ON POWER POLE TO THE NW. SPIKE IS AT RECORD BEARING AND DISTANCE SHOWN ON TAG. USFS SURVEYOR MICHAEL LANGE RESEARCHED CORNER FOR ANY RECORD OF SPIKE OR TAG, NONE WAS FOUND. MIKE FELT THAT THE SPIKE WAS MOST LIKELY NOT SET BY A FOREST SERVICE SURVEYOR, BUT SOMEONE ELSE THAT WORKS FOR THE USFS. HE SUGGESTED THAT IT NOT BE CONSIDERED GOOD EVIDENCE OF THE CORNER, AND THAT IT WAS ONLY AN ESTIMATED POSITION FOR THE CORNER. REMOVED CABIN SPIKE AND RE-STAMPED TAG WITH BEARING AND DISTANCE TO A 5/8" X 36" IRON AND BRASS CAP SET BY SINGLE PROPORTIONATE MEASURE BETWEEN THE SE CORNER OF SECTION 36, T22N, R12W, AND THE NE CORNER OF SECTION 24, T22N, R12W. IRON AND BRASS CAP IS IN SOUTH EDGE OF EAST-WEST TRAIL ROAD, 3' EAST OF OLD ROAD GRADE CENTERLINE, AND 43' WEST AND 20' NORTH OF NW CORNER OF PINE PLANTATION. THIS CORNER IS ACCEPTED AS A CAREFUL AND FAITHFUL RE-ESTABLISHMENT OF THE POSITION OF THE ORIGINAL CORNER.

C. Description of monument for corner and accessories established to perpetuate locating the position of the corner:

M-9 SECTION CORNER COMMON TO SECTIONS 24 & 25, T22N, R12W AND SECTIONS 19 & 30, T22N, R11W
5/8" X 36" IRON & BRASS CAP STAMPED: CJP, 1998, 24, 25, 19, 30, 39095
N48°W POWER POLE 60.38' (USFS TAG)
N55°E 14" BEECH 53.68'
S64°E 9" RED PINE 61.41'
N30°E 12" MAPLE 46.36'

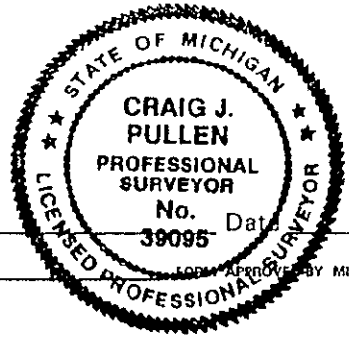

Peer Group Reviewed and Approved
Date: 12 Dec 98
Richard D. Wilcox
Richard D. Wilcox, Wexford County Surveyor

Signed by *Craig J. Pullen*
Surveyor's Michigan License No. 39095

December 3, 1998