

RECEIVED

1996 NOV -4 PM 3: 36

LAND CORNER RECORDATION CERTIFICATE
Filing Requirement of Act 74, Mich. P.A. 1970

Linda Loughmiller
WEXFORD COUNTY, MI
REGISTER OF DEEDS

Table with columns: For corners in WEXFORD (County), Located In, Corner Code #. Rows include Public Land Survey, Property Controlling in Section, Miscellaneous Property in Section.

MONUMENTATION

MAY 20 1997

COMMISSION

Register of Deeds Stamp & File Number

4. Lot No. , Recorded Plat
5. Private Claims

Grid table with columns A-M and rows 2-13. Contains numbers 1-36.

I, CRAIG J. PULLEN, in a field survey on MAY 22, 19 96, do hereby certify that under requirements of P.A. 74, Michigan P.A. of 1970, the corner points mentioned in lines 1 and 2 above were in conformance with regulations and rules therefore as required in the current manual of survey instructions of the United States Department of the Interior, Bureau of Land Management or by a decree of a Court of Law and/or that the corner points mentioned in lines 3, 4 and 5 above were in conformance with the rules of the Michigan Board of Professional Surveyors or by a Decree of a Court of Law; established, re-established, monumented, re-monumented, recovered, found as expressed below:

NOTE: Not more than 4 corners, all in the same town and range, may be recorded on this certificate.

A. Description of original monument and accessories and/or subsequent restoration:

- M-7 1837 ORIGINAL GLO SURVEY BY J. BRINK SUGAR 12 S51W 38 LYNN 10 N74W 58
1891 & 1892 A.J. TEED SURVEYS IN SEC.18 & 19, T22N, R9W & SEC.24, T22N, R10W CEDAR STAKE IN CROSSWAY BETWEEN TWO LOGS PUT IN NEW STAKE
1907 DEVOE SURVEY IN SEC.18, T22N, R9W FOUND OLD POST REPLACED WITH GAS PIPE TEL. POLE S85°E 81 TEL. POLE N24½E 66½
1972 GRANGER ENG. SURVEY IN SEC.24, T22N, R10W L.248, P.841 AND L.C.R.C. L.1, P.147 BY J. GRANGER, PS #16041 ½" IRON IN MON. BOX N50°E 49.1' SIGN POST S30°E 89.0' T.P. S40°E 58.2' 2" PINE
1977 GRANGER ENG SURVEY IN SEC.18, T22N, R9W L.1, P.558 BY J. FLETCHER, PS #19830 P.POLE N42°E 66.42' P.POLE S68°W 79.80' P.POLE S62°E 69.97'
1981 JOHN MILLETICS, PS #25859 SURVEY IN SEC.13, T22N, R10W L.1, P.876 MON BOX WITS SAME AS GRANGER (1972)
1984 R. MITCHELL, PS #28417 SURVEY IN SEC.19, T22N, R9W IRON IN MON. BOX
1987 GRANGER ENG. SURVEY IN SEC.18, T22N, R9W L.65, P.152 BY J. RAY, PS #25869 WEXFORD COUNTY MONUMENT WITS SAME AS 1972 AND 1977. NEW WIT S40°W 57.95' 6" RED PINE
1987 J.L. WILCOX & ASSOC. SURVEY IN SEC.19, T22N, R9W L.66, P.530 BY J.L. WILCOX, PS #14102 IRON IN MON BOX WITS SAME AS GRANGER (1972)
1995 J.D. GEERS, PS #33977 L.C.R.C. L.4, P.397 FD ½" IRON IN MON. BOX SET IRON & CAP IN MON BOX N45°E 66.89' POWER POLE S80°W 102.37' 36" MAPLE N40°W 66.85' 10" R. PINE S50°E 89.02' POWER POLE

B. Description of corner evidence found and/or method applied in restoring or reestablishing corner:

M-7 FOUND ½" IRON IN MONUMENT BOX IN CENTERLINE 32 ROAD AND 0.5' WEST OF CENTERLINE 37 ROAD AND 4 PREVIOUS WITNESSES. REPLACED IRON WITH 5/8" X 36" IRON AND BRASS CAP. DISTANCE TO E¼ CORNER SECTION 24, T22N, R10W IS 2596.85' (2592.48'-TEED) AND TO E¼ CORNER SECTION 13 IS 2630.03' (2629.44'-TEED). THIS CORNER IS ACCEPTED AS THE BEST AVAILABLE EVIDENCE OF THE POSITION OF THE ORIGINAL CORNER.


Peer Group Reviewed and Approved

Date: 31 Oct 96

Richard D. Wilcox, Wexford County Surveyor

C. Description of monument for corner and accessories established to perpetuate locating the position of the corner:

- M-7 SECTION CORNER COMMON TO SECTIONS 13 AND 24, T22N, R10W AND SECTIONS 18 AND 19, T22N, R9W
5/8" X 36" IRON AND BRASS CAP STAMPED: 1996, 13, 24, 18, 19, CJP, 39095
S30°E POST AT TELEPHONE PEDESTAL 89.0'
S40°W 6" RED PINE 57.95'
N42°E POWER POLE 66.42'
S72°W 24" MAPLE 102.16'

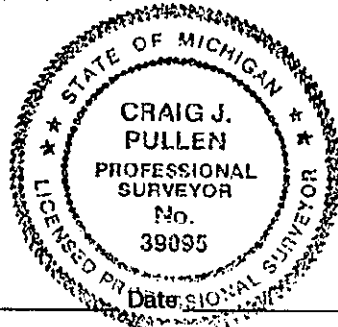

Signed by Craig J. Pullen
Surveyor's Michigan License No. 39095

OCTOBER 9, 1996