

RECEIVED

1996 NOV -4 PM 3: 36

LAND CORNER RECORDATION CERTIFICATE

Filing Requirement of Act 74, Mich. P.A. 1976

For corners in WEXFORD

(County)

Located In:

Corner Code #

WEXFORD COUNTY, MI REGISTER OF DEEDS

SURVEY & REMONUMENTATION

MAY 20 1997

COMMISSION

Register of Deeds Stamp & File Number

1. Public Land Survey	T	22N	R	10W	M-8
	T		R		
	T		R		
	T		R		
2. Property Controlling in Section	S		T	R	
	S		T	R	
3. Miscellaneous Property in Section	S		T	R	
	S		T	R	

4. Lot No. _____, Recorded Plat _____
5. Private Claims _____

A	B	C	D	E	F	G	H	I	J	K	L	M
2	6	5	4	3	2	1						
3												
4	7	8	9	10	11	12						
5												
6	18	17	16	15	14	13						
7												
8	19	20	21	22	23	24						
9												
10	30	29	28	27	26	25						
11												
12	31	32	33	34	35	36						
13												

I, CRAIG J. PULLEN, in a field survey on MAY 22, 1996, do hereby certify that under requirements of P.A. 74, Michigan P.A. of 1970, the corner points mentioned in lines 1 and 2 above were in conformance with regulations and rules therefore as required in the current manual of survey instructions of the United States Department of the Interior, Bureau of Land Management or by a decree of a Court of Law and/or that the corner points mentioned in lines 3, 4 and 5 above were in conformance with the rules of the Michigan Board of Professional Surveyors or by a Decree of a Court of Law; established, re-established, monumented, re-monumented, recovered, found as expressed below:

NOTE: Not more than 4 corners, all in the same town and range, may be recorded on this certificate.

A. Description of original monument and accessories and/or subsequent restoration:

- M-8 1837 ORIGINAL GLO SURVEY BY J. BRINK WOOD POST SUGAR 7 S66W 16 SUGAR 9 N66½W 41 1891 & 1892 A.J. TEED SURVEYS IN SEC.24, T22N, R10W AND SEC.19, T22N, R9W OK DID NOT DISTURB
- 1977 WEXFORD COUNTY ROAD COMMISSION WITNESS BOOK ½" PIPE 20" BEECH S85°W 40.95' QUAD ELM N85°E 36.40'
- 1972 GRANGER ENG. SURVEY L.248, P.841 IN SEC.24, T22N, R10W AND L.C.R.C. L.1, P.147 BY J. GRANGER, PS #16041 ½" IRON IN MON. BOX N35°E 42.2' T.P. S80°W 42.0' 20" BEECHNUT
- 1975 J.L. WILCOX & ASSOC. SURVEY IN SEC.19, T22N, R9W L.1, P.345 AND L.C.R.C. L.2, P.770 BY J.L. WILCOX, PS #14102 ½" PIPE IN MON. BOX S80°W 20" BEECH 42.24' N50°W SE COR. HSE FON. 115.60' EAST 10" ELM 137.40'
- 1984 GRANGER ENG. SURVEY IN SEC.19, T22N, R9W L.2, P.131 BY J. RAY, PS #25869 ½" PIPE IN MON. BOX WITS SAME AS WILCOX (1975)
- 1987 J.L. WILCOX & ASSOC. SURVEY BY J.L. WILCOX, PS #14102 L.66, P.530 ½" PIPE IN MON. BOX WITS SAME AS 1975

B. Description of corner evidence found and/or method applied in restoring or reestablishing corner:

M-8 FOUND ½" PIPE IN MONUMENT BOX 0.5' EAST OF CENTERLINE 37 ROAD AND IN LINE WITH FENCE TO EAST. ALSO FOUND 2 PREVIOUS WITNESSES. REPLACED PIPE WITH 5/8" X 36" IRON AND BRASS CAP. DISTANCE TO SE CORNER SECTION 24, T22N, R10W IS 2551.26' (2548.92'-TEED) AND TO NE CORNER SECTION 24 2596.85' (2592.48'-TEED). THIS CORNER IS ACCEPTED AS THE BEST AVAILABLE EVIDENCE OF THE POSITION OF THE ORIGINAL CORNER.


Peer Group Reviewed and Approved

Date: 31 Oct 96

Richard D. Wilcox
Richard D. Wilcox, Wexford County Surveyor

C. Description of monument for corner and accessories established to perpetuate locating the position of the corner:

- M-8 ¼ CORNER COMMON TO SECTION 24, T22N, R10W AND SECTION 19, T22N, R9W
- 5/8" X 36" IRON AND BRASS CAP STAMPED: 1996, ¼, 24, 19, CJP, 39095
- S80°W 30" BEECH 42.24'
- N50°W SE CORNER HOUSE FOUNDATION 115.60'
- N39°E 6" CHERRY 47.29'
- N75°E 4" ELM 36.36'

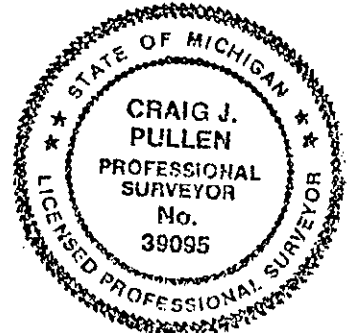

Signed by Craig J. Pullen

Date OCTOBER 9, 1996

Surveyor's Michigan License No. 39095