

RECEIVED

1996 NOV -4 PM 3: 36

LAND CORNER RECORDATION CERTIFICATE
Filing Requirement of Act 74, Mich. P.A. 1970

Linda Loughmiller
WEXFORD COUNTY, MI
REGISTER OF DEEDS

For corners in WEXFORD (County) Located In: Corner Code #

- 1. Public Land Survey T 22N R 10W M-9
2. Property Controlling in Section S T R
3. Miscellaneous Property in Section S T R

SURVEY & MONUMENTATION
MAY 24 1997
Register of Deeds Stamp & File Number

- 4. Lot No. , Recorded Plat
5. Private Claims

Grid table with columns A-M and rows 1-13. Cell 10,36 contains a black dot.

I, CRAIG J. PULLEN, in a field survey on AUGUST 15, 1996, do hereby certify that under requirements of P.A. 74, Michigan P.A. of 1970, the corner points mentioned in lines 1 and 2 above were in conformance with regulations and rules therefore as required in the current manual of survey instructions of the United States Department of the Interior, Bureau of Land Management or by a decree of a Court of Law and/or that the corner points mentioned in lines 3, 4 and 5 above were in conformance with the rules of the Michigan Board of Professional Surveyors or by a Decree of a Court of Law; established, re-established, monumented, re-monumented, recovered, found as expressed below:

NOTE: Not more than 4 corners, all in the same town and range, may be recorded on this certificate.


- A. Description of original monument and accessories and/or subsequent restoration:
1837 ORIGINAL GLO SURVEY BY J. BRINK WOOD POST HEMLOCK 10 S53W 24 HEMLOCK 16 N1W 30
1891 & 1892 A.J. TEED SURVEYS IN SEC.24, T22N, R10W AND SEC.19, T22N, R9W GOOD STAKE AND ONE WIT. PUT IN STONE AND NEW STAKE
1897 A.J. TEED SURVEY IN SEC.25, T22N, R10W FOUND GOOD STAKE & STONES BY GOV. HEM SW
1908 D.E. TEED SURVEY IN SEC.24, T22N, R10W IRON ROD & STONE ELM 14 N19 1/2 E 97.1' FENCE POST S45 1/2 W 40.7'
1977 WEXFORD COUNTY ROAD COMMISSION SURVEY IN SEC.25, T22N, R10W CORNER SHOWN AS IN NO CORNER DESC. GIVEN OR WITNESSES. DISTANCE TO SE COR. SEC.25 5250.67 AND DISTANCE TO NW COR SEC.25 5354.38'
1974 J. SWITALSKI, PS #13045 L.C.R.C. L.2, P.684 5/8" PIPE IN MONUMENT BOX AT INTERSECTION 34 AND 37 RDS. GUY POLE N33 E 62.16' GUY POLE S67 W 56.30' NW CORNER GOMOLAK STORE S40 E 130.57'
1975 J.L. WILCOX & ASSOC. SURVEY IN SEC.19, T22N, R10W BY J.L. WILCOX, PS #14102 AND L.C.R.C. L.2, P.770 FOUND 1/2" PIPE IN MONUMENT BOX S45 W FE COR. POST 43.20' N45 E T. POLE 62.30' S30 E 8" ELM 103.10'
1983 & 1984 GRANGER ENG. SURVEYS IN SEC.25, T22N, R10W AND SEC.19, T22N, R9W, L.2, P.131, BY J. RAY, PS #25869 1/2" PIPE IN MON. BOX WITNESSES SAME AS WILCOX (1975)
1991 WADE-TRIM/GRANGER SURVEY IN SEC.25, T22N, R10W, L.72, P.8 AND L.C.R.C. L.4, P.117 BY J. RAY, PS #25869 FD 1" PIPE IN MON. BOX INTERSECTION 34 & 37 RDS. FITS OCCUPATION S12 E 8" ELM 103.23' S54 W FE. POST 43.67' N26 W RD. SIGN 47.11' N28 E E. FACE OF CONC R/W MARKER 81.89'
1994 WILCOX ASSOC. SURVEY IN SEC.25, T22N, R10W, L.73, P.410, BY J.D. GEERS, PS #33977 1/2" IRON/CAP IN MON. BOX WITS SAME AS WADE-TRIM (1991)
1994 F. FINNERTY, PS #16038 SURVEY IN SEC.25, T22N, R10W MON. BOX NO WITS.

B. Description of corner evidence found and/or method applied in restoring or reestablishing corner:

M-9 FOUND 1/2" X 18" IRON IN MONUMENT BOX IN CENTERLINE 34 RD AND CENTERLINE 37 RD AND 2 PREVIOUS WITNESSES. REPLACED IRON WITH 5/8" X 36" IRON AND BRASS CAP. DISTANCE TO E 1/4 CORNER SECTION 24, T22N, R10W IS 2551.26' (2548.92'-TEED) AND TO E 1/4 CORNER SECTION 25, T22N, R10W IS 2635.10' (2633.40'-TEED). THIS CORNER IS ACCEPTED AS THE BEST AVAILABLE EVIDENCE OF THE POSITION OF THE ORIGINAL CORNER.

C. Description of monument for corner and accessories established to perpetuate locating the position of the corner:

- M-9 SECTION CORNER COMMON TO SECTIONS 24 AND 25, T22N, R10W AND SECTIONS 19 AND 30, T22N, R9W
5/8" X 36" IRON AND BRASS CAP STAMPED: 1996, 24, 25, 19, 30, CJP, 39095
S45 E GUY AND LIGHT POLE 44.81'
S17 E 12" ELM 103.40'
N30 E TOP CENTER TELEPHONE PEDESTAL 73.05'
N52 W 4" POPLAR 126.56'
N76 W SW CORNER FENCE POST 156.46'
S40 E NW CORNER STORE 130.57'

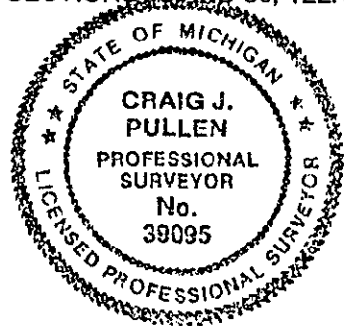

Signed by Craig J. Pullen Date OCTOBER 9, 1996
Surveyor's Michigan License No. 39095