

RECEIVED

1996 NOV -4 PM 3: 36

LAND CORNER RECORDATION CERTIFICATE
Filing Requirement of Act 74, Mich. P.A. 1970

Linda Loughmiller
WEXFORD COUNTY, MI
REGISTER OF DEEDS

For corners in WEXFORD (County) Located In: Corner Code #
1. Public Land Survey T 22N R 10W M-10
2. Property Controlling In Section S T R
3. Miscellaneous Property in Section S T R
4. Lot No. , Recorded Plat
5. Private Claims

SURVEY &
REMONUMENTATION
MAY 20 1997
COMMISSION
Register of Deeds Stamp & File Number

Grid table with columns A-L and rows 2-13. Contains numbers 6-36 in a grid pattern.


I, CRAIG J. PULLEN, in a field survey on JULY 24, 1996, do hereby certify that under requirements of P.A. 74, Michigan P.A. of 1970, the corner points mentioned in lines 1 and 2 above were in conformance with regulations and rules therefore as required in the current manual of survey instructions of the United States Department of the Interior, Bureau of Land Management or by a decree of a Court of Law and/or that the corner points mentioned in lines 3, 4 and 5 above were in conformance with the rules of the Michigan Board of Professional Surveyors or by a Decree of a Court of Law; established, re-established, monumented, re-monumented, recovered, found as expressed below:

NOTE: Not more than 4 corners, all in the same town and range, may be recorded on this certificate.

- A. Description of original monument and accessories and/or subsequent restoration:
1837 ORIGINAL GLO SURVEY BY J. BRINK WOOD POST TAMARACK 10 S23W 59 TAMARACK 8 N60W 13
1897 A.J. TEED SURVEY IN SEC.25, T22N, R10W STAKE LAYING ON GROUND IN WATER. BOTH GOV. WITS OK. SET STAKE UP AS PER GOV. WITS. BOB LONG HAS A STAKE ABOUT A ROD TO SW - NO GOOD.
1909 D.E. TEED SURVEY IN SEC.30, T22N, R9W FOUND GOV. WITS AND BOB'S STAKE. BOB'S STAKE IS 10.90' SOUTH AND 10.16' WEST OF CORRECT LOCATION. THINK SOMEBODY PULLED UP CORRECT STAKE. DID NOT SET NEW STAKE AS I DID NOT HAVE GOV'T NOTES WITH ME. WIT. FROM BOB LONG'S STAKE TAM 10 S74E 22 1/2 FT. TAM 14 S12W 25 1/2 FT.
1974 J. SWITALSKI, PS #13045 L.C.R.C. L2, P.682 SET CORNER HALFWAY & ON LINE BETWEEN NW COR & SW COR SEC.30. SET PUNCH MARKED 40" AXLE SHAFT WITH PINION GEAR 7" BELOW SURFACE OF GRAVEL 12' TAMARACK N29°E 134.00' 6" MAPLE N11°W 131.43' 20" MAPLE S43°E 144.76' 3/4" PIPE SOUTH 9.82' GUY POLE N84°E 76.52'
1984 GRANGER ENG. SURVEY IN SEC.25, T22N, R10W BY J. RAY, PS #25869 MON. BOX
1988 S. BARNETT, PS #16923 SURVEY IN SEC.25, T22N, R10W FOR USFS L.67, P.524 AND L.C.R.C. L.4, P.40 WEXFORD COUNTY MONUMENT TEL. POLE N81°E 78.86' MAPLE 8" S30°E 111.80' W. PINE 11" N7°W 205.10' CARSONITE POST 21.7' WEST
1991 WADE-TRIM/GRANGER SURVEY IN SEC.25, T22N, R10W, BY J. RAY, PS #25869, L.72, P.8 WEXFORD COUNTY MONUMENT IN MONUMENT BOX WITS SAME AS S. BARNETT (1988)
1992 WADE-TRIM/GRANGER SURVEY IN SEC.30, T22N, R9W, BY J. RAY, PS #25869, L.72, P.561 WEXFORD CO. MON. IN MON. BOX N75°E P. POLE 78.90' S72°E MAPLE CLUMP 107.30' N40°E FE. POST 63.40' N85°W BOLT IN S. GATE POST 30.04'
1994 WILCOX ASSOC. SURVEY IN SEC.25, T22N, R10W, BY J.D. GEERS, PS #33977 WEXFORD CO. MON. IN MON. BOX WITS SAME AS BARNETT (1988)

B. Description of corner evidence found and/or method applied in restoring or reestablishing corner:
M-10 FOUND WEXFORD COUNTY MONUMENT IN MONUMENT BOX IN GOOD CONDITION IN CENTERLINE OF 37 ROAD AND CENTERLINE OF 34 1/2 ROAD TO EAST, AND 2 PREVIOUS WITNESSES. POSITION OF THE CORNER IS ON LINE BETWEEN NE CORNER AND SE CORNER SECTION 25, T22N, R10W, BUT IT IS NOT HALF THE DISTANCE. IT IS 2635.10 FEET TO NORTH AND 2615.62 FEET TO SOUTH. THIS CORNER IS ACCEPTED AS THE BEST AVAILABLE EVIDENCE OF THE POSITION OF THE ORIGINAL CORNER.

C. Description of monument for corner and accessories established to perpetuate locating the position of the corner:
M-10 1/4 CORNER COMMON TO SECTION 25, T22N, R10W AND SECTION 30, T22N, R9W
WEXFORD COUNTY MONUMENT IN MONUMENT BOX STAMPED: 1996, 1/4, 25, 30, CJP, 39095
N81°E TELEPHONE POLE 78.84'
N48°E 5" POPLAR 67.12'
S42°E PK IN END OF CULVERT 47.49'
N85°W BOLT IN S. GATE POST 29.97'

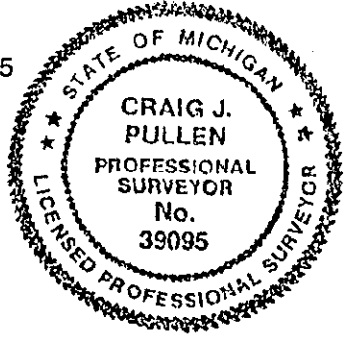

Signed by Craig J. Pullen Date OCTOBER 9, 1996
Surveyor's Michigan License No. 39095