

RECEIVED

1996 NOV -4 PM 3:38

LAND CORNER RECORDATION CERTIFICATE
Filing Requirement of Act 74, Mich. P.A. 1970

Linda Loughmiller
WEXFORD COUNTY, MI
REGISTER OF DEEDS

For corners in WEXFORD (County) Located In: Corner Code #

- 1. Public Land Survey T 22N R 10W M-11
2. Property Controlling in Section S T R
3. Miscellaneous Property in Section S T R

SURVEY & MONUMENTATION

MAY 20 1997

Register of Deeds Stamp & File Number

4. Lot No. , Recorded Plat
5. Private Claims

Grid table with columns A-M and rows 2-13. Contains numerical data points for survey locations.

I, CRAIG J. PULLEN, in a field survey on MAY 22, 1996, do hereby certify that under requirements of P.A. 74, Michigan P.A. of 1970, the corner points mentioned in lines 1 and 2 above were in conformance with regulations and rules therefore as required in the current manual of survey instructions of the United States Department of the Interior, Bureau of Land Management or by a decree of a Court of Law and/or that the corner points mentioned in lines 3, 4 and 5 above were in conformance with the rules of the Michigan Board of Professional Surveyors or by a Decree of a Court of Law; established, re-established, monumented, re-monumented, recovered, found as expressed below:

NOTE: Not more than 4 corners, all in the same town and range, may be recorded on this certificate.

A. Description of original monument and accessories and/or subsequent restoration:

- M-11 1837 GLO SURVEY BY J. BRINK WOOD POST BIRCH 8 S33 1/2 W 21 CEDAR 10 N38 W 33
1892 D.E. TEED SURVEY IN SECTION 31, T21N, R9W FOUND STAKE & WITS OK.
1977 WEXFORD COUNTY ROAD COMMISSION SURVEY IN SECTIONS 25 AND 36, T22N, R10W, SHOWS DISTANCE FROM NE COR. SEC.25 TO SE COR. SEC.36 AS 10501.33'. ALSO SHOWS CORNER COMMON TO SEC.25 & 36 AT THE SPLIT OF THAT DISTANCE - 5250.67' BOTH WAYS.
1972 M. MCCLUNG, PS #13037 L.C.R.C. L.1, P.244 3/4" REROD 10" MAPLE N30W 56.7' 6" MAPLE N30E 56.6' 10" MAPLE S30W 58.9'
1973 WILCOX & ERICKSON SURVEY IN SECTION 36, T22N, R10W L.1, P.113 AND L.C.R.C. L.2, P.569 BY J. ERICKSON, PS #16929 FOUND 1" ROD, REPLACED WITH WEXFORD COUNTY MONUMENT N30°E 9.52' 7" ELM S70°E 16.75' 5" ELM N70°W 18.62' 4" ELM
1974 J. SWITALSKI, PS #13045 L.C.R.C. L.2, P.684 REGULATION CORNER MONUMENT 7" ASH N60°W 18.62' 12" ASH N30°E 9.52' 6" ASH S80°E 16.75'
1976 J.L. WILCOX & ASSOC. SURVEY L.1, P.454 BY J. L. WILCOX, PS #14102 AND L.C.R.C. L.2, P.684 WEXFORD COUNTY MONUMENT SAME WITS AS 1973.
1988 S. BARNETT, PS #16923 SURVEY IN SECTION 25, T22N, R10W FOR U.S.F.S. L.67, P.524 AND L.C.R.C. L.4, P.43 WEXFORD COUNTY MONUMENT B. ASH 4" S77W 15.48' B. ASH 6" S73E 16.69' B. ASH 5" S06E 29.06' CARSONITE POST SOUTH 1.0' CENTERLINE OF ROAD 63.0' NORTH

B. Description of corner evidence found and/or method applied in restoring or reestablishing corner:


M-11 FOUND WEXFORD COUNTY MONUMENT 63.0' SOUTH OF THE CENTERLINE OF 13TH STREET AND ALL 1988 WITNESSES. DISTANCES FROM THIS POSITION ARE 5252.48' (5250.67'-R) TO SE CORNER SECTION 36 AND 5250.72' (5250.67'-R) TO NE CORNER SECTION 25 AND A 6 MINUTE DEFLECTION AT THIS POSITION. THE CORNER IS PRESUMED TO BE IN THE SAME LOCATION AS SHOWN IN THE ROAD COMMISSION SURVEY. REPLACED MONUMENT WITH 5/8" X 36" IRON AND BRASS CAP. THIS CORNER IS ACCEPTED AS THE BEST AVAILABLE EVIDENCE OF THE POSITION OF THE ORIGINAL CORNER.

Peer Group Reviewed and Approved

Date: 31 Oct 96
Richard D. Wilcox, Wexford County Surveyor

C. Description of monument for corner and accessories established to perpetuate locating the position of the corner:

M-11 SECTION CORNER COMMON TO SECTIONS 25 AND 36, T22N, R10W AND SECTIONS 30 AND 31, T22N, R9W
5/8" X 36" IRON WITH BRASS CAP STAMPED: 25, 36, 30, 31, 1996, CJP, 39095
S77°W 7" ASH 15.48'
S73°E 9" ASH 16.69'
N06°W 8" ASH 29.06'
N47°E 12" ASH 9.70'
SOUTH CARSONITE POST 1.0'

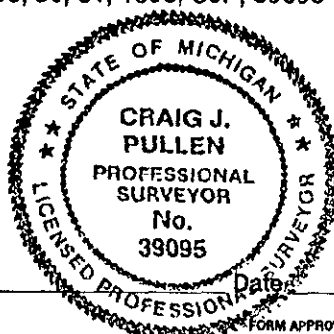

Signed by Craig J. Pullen
Surveyor's Michigan License No. 39095

OCTOBER 9, 1996