

RECEIVED

1996 NOV -4 PM 3:36

LAND CORNER RECORDATION CERTIFICATE
Filing Requirement of Act 74, Mich. P.A. 1970

Linda Loughmiller
WEXFORD COUNTY, MI
REGISTER OF DEEDS

For corners in WEXFORD

(County)

Located In:

Corner Code #

- 1. Public Land Survey T 22N R 10W M-12
2. Property Controlling in Section S T R
3. Miscellaneous Property in Section S T R

SURVEY &
REMONUMENTATION

MAY 20 1997

COMMISSION

Register of Deeds Stamp & File Number

- 4. Lot No. , Recorded Plat
5. Private Claims

Grid table with columns A-M and rows 2-13. Cell 12,36 contains a black dot.

I, CRAIG J. PULLEN, in a field survey on AUGUST 25, 1996, do hereby certify that under requirements of P.A. 74, Michigan P.A. of 1970, the corner points mentioned in lines 1 and 2 above were in conformance with regulations and rules therefore as required in the current manual of survey instructions of the United States Department of the Interior, Bureau of Land Management or by a decree of a Court of Law and/or that the corner points mentioned in lines 3, 4 and 5 above were in conformance with the rules of the Michigan Board of Professional Surveyors or by a Decree of a Court of Law; established, re-established, monumented, re-monumented, recovered, found as expressed below:

NOTE: Not more than 4 corners, all in the same town and range, may be recorded on this certificate.

A. Description of original monument and accessories and/or subsequent restoration:

- M-12 1837 ORIGINAL GLO SURVEY BY J. BRINK WOOD POST HEM 14 N67W 31 HEM 10 S34W 29
1908 D.E. TEED SURVEY IN SECTION 31, T22N, R9W FOUND BOTH GOV. WITNESSES AND HOLE WITH REMAINS OF OLD STAKE HEM 8 N17 1/2 W 19.5'
1973 & 1974 J.L. WILCOX & ASSOC. SURVEY IN SEC.36, T22N, R9W L.1, P.113 & L.1, P.263 E 1/4 CORNER NOT SHOWN. N 1/8 COR. ON EAST SEC. LINE SHOWN AS A PRORATION OF THE DISTANCE FROM THE NE COR. TO SE COR. OF SEC.36. THE 5250.67' DISTANCE IS DENOTED AS W.C.R.C. RECORD MEASUREMENT.
1976 J.L. WILCOX & ASSOC. SURVEY IN SECTION 36, T22N, R10W L.1, PL.454 BY J.L. WILCOX, PS #14102 AND L.C.R.C., L.2, P.824 FOUND 3" PIPE, ADDED STANDARD WEXFORD COUNTY MONUMENT N70°W 24" SPRUCE 26.29' N60°E 24" SPRUCE 10.28' S10°W 8" TRI MAPLE 17.90'

B. Description of corner evidence found and/or method applied in restoring or reestablishing corner:

- M-12 FOUND WEXFORD COUNTY MONUMENT IN EXCELLENT CONDITION ON NORTHERLY END OF HEMLOCK ISLAND AND 3 WITNESSES FROM 1976. THIS CORNER IS ACCEPTED AS THE BEST AVAILABLE EVIDENCE OF THE POSITION OF THE ORIGINAL CORNER.


Peer Group Reviewed and Approved

Date: 31 Oct 96

Richard D. Wilcox, Wexford County Surveyor

C. Description of monument for corner and accessories established to perpetuate locating the position of the corner:

- M-12 1/4 CORNER COMMON TO SECTION 36, T22N, R10W AND SECTION 31, T22N, R9W WEXFORD COUNTY MONUMENT
N75°W 12" MAPLE 31.05'
N70°W 24" HEMLOCK 26.29'
N60°E 24" HEMLOCK 10.28'
S10°W 8" TRI MAPLE 17.92'
N23°W 16" TWIN MAPLE 30.55'

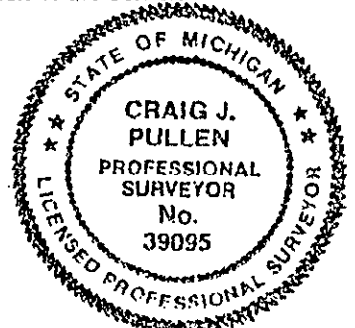

Signed by Craig J. Pullen

Date OCTOBER 9, 1996

Surveyor's Michigan License No. 39095

FORM APPROVED BY MICHIGAN STATE BOARD OF PROFESSIONAL SURVEYORS, JAN. 28, 1971
REVISED MAY 14, 1975
REVISED JAN., 1983