

APR 16 1999

RECEIVED

1998 DEC 30 AM 10:18

SECTION

LAND CORNER RECORDATION CERTIFICATE
Filing Requirement of Act 74, Mich. P.A. 1970

Linda Loughmiller
WEXFORD COUNTY, MI
REGISTER OF DEEDS

For corners in

WEXFORD
(County)

Located In: Corner Code #

1. Public Land Survey T 22N R 12W M-6

- 2. Property Controlling S___
in Section S___
- 3. Miscellaneous S___
Property in Sec. S___

Common to:

A-6 T22N, R11W

Register of Deeds Stamp & File Number

- 4. Lot No. _____, Recorded Plat _____
- 5. Private Claims _____

I, CRAIG J. PULLEN, PS, in a field survey on NOVEMBER 3, 1998, do hereby state that under requirements of P.A. 74, Michigan P.A. of 1970, the corner points mentioned in lines 1 and 2 above were in conformance with regulations and rules therefore as required in the current manual of survey instructions of the United States Department of the Interior, Bureau of Land Management or by a decree of a Court of Law and/or that the corner points mentioned in lines 3, 4 and 5 above were in conformance with the rules of the Michigan Board of Land Surveyors or by a Decree of a Court of Law; established, re-established, monumented, recovered, found as expressed below:

NOTE: Not more than 2 corners, all in the same town and range, may be recorded on this certificate.

	A	B	C	D	E	F	G	H	I	J	K	L	M
1													
2		6		5		4		3		2		1	
3													
4		7		8		9		10		11		12	
5													
6		18		17		16		15		14		13	
7													
8		19		20		21		22		23		24	
9													
10		30		29		28		27		26		25	
11													
12		31		32		33		34		35		36	
13													

A. Description of original monument and accessories and/or subsequent restoration:

M-6 1838 G.L.O. SURVEY BY J. BRINK WOOD POST BEECH 10 N49W 28 BEECH 11 S7W 29
1898 A.J. TEED SURVEY IN SECTION 18, T22N, R11W, NO CORNER DESCRIPTION OR WITNESSES GIVEN.
CORNER WAS USED TO ESTABLISH PLAT OF THE VILLAGE OF HARRIETTE. DISTANCE TO NW CORNER OF SECTION 18 SHOWN AS 2619.28' AND DISTANCE TO SW CORNER OF SAID PLAT IS SHOWN AS 991.25'. DISTANCE TO SW CORNER SECTION SHOWN AS 2641.75.

B. Description of corner evidence found and/or method applied in restoring or reestablishing corner:


M-6 FOUND OLD CEDAR POST AT INTERSECTION OF GOOD (STRAIGHT) FENCE LINES NORTH, SOUTH, AND WEST. DISTANCE TO NW CORNER OF SECTION 18 IS 2620.75' (2619.28'-TEED) AND DISTANCE TO SW CORNER OF THE PLAT OF THE VILLAGE OF HARRIETTE (BENT 1/2" PIPE) IS 993.68' (991.25'-TEED). THE DISTANCE TO THE SW CORNER OF SECTION 18, T22N, R11W IS 2632.42' (2641.75'-TEED). THE OLD CEDAR POST IS 0.25' WEST OF A STRAIGHT LINE BETWEEN THE NW CORNER AND SW CORNER OF SECTION 18, T22N, R11W. THE SW CORNER OF SAID PLAT IS 1.5' EAST OF THE LINE BETWEEN THE OLD CEDAR POST AND THE NW CORNER OF SECTION 18. REPLACED OLD POST WITH 5/8" X 36" IRON AND BRASS CAP, PUT OLD POST IN NORTH OF AND ADJACENT TO 5/8" IRON. THE IRON IS AT THE SE CORNER OF A HARD WOODS AND 25' +/- WEST OF THE WEST EDGE PLANTED RED PINES. THIS CORNER IS ACCEPTED AS THE BEST AVAILABLE EVIDENCE OF THE POSITION OF THE CORNER.

C. Description of monument for corner and accessories established to perpetuate locating the position of the corner:

M-6 1/4 CORNER COMMON TO SECTION 13, T22N, R12W & SECTION 18, T22N, R11W
5/8" X 36" IRON & BRASS CAP STAMPED: CJP, 1998, 1/4, 13, 18, 39095
N84°E 12" MAPLE 26.61'
S1°E 12" TWIN MAPLE 4.74'
N3°W 12" MAPLE 14.55'
N44°W 24" BEECH 26.58'

Peer Group Reviewed and Approved

Date: 11/9/98
Richard D. Wilcox
Richard D. Wilcox, Wexford County Surveyor

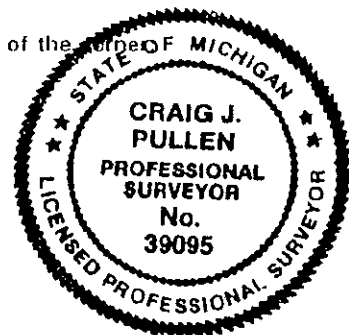

Signed by *Craig J. Pullen* Date November 6, 1998

Surveyor's Michigan License No. 39095 FORM APPROVED BY MICHIGAN STATE BOARD OF PROFESSIONAL SURVEYORS, JAN. 28, 1971