

APR 16 1999

SECTION

LAND CORNER RECORDATION CERTIFICATE
Filing Requirement of Act 74, Mich. P.A. 1970

RECEIVED

1998 DEC 30 AM 10:19

Linda Loughmiller
WEXFORD COUNTY, MI
REGISTER OF DEEDS

For corners in

WEXFORD
(County)

Located In:

Corner Code #

1. Public Land Survey

T 22N R 12W

M-12

2. Property Controlling
in Section

S
S

3. Miscellaneous
Property in Sec.

S
S

Common to
A-12 T 22N, R 11W

4. Lot No. _____, Recorded Plat _____

5. Private Claims _____

Register of Deeds Stamp & File Number

I, CRAIG J. PULLEN, PS, in a field survey on NOVEMBER 24, 1998, do hereby state that under requirements of P.A. 74, Michigan P.A. of 1970, the corner points mentioned in lines 1 and 2 above were in conformance with regulations and rules therefore as required in the current manual of survey instructions of the United States Department of the Interior, Bureau of Land Management or by a decree of a Court of Law and/or that the corner points mentioned in lines 3, 4 and 5 above were in conformance with the rules of the Michigan Board of Land Surveyors or by a Decree of a Court of Law; established, re-established, monumented, recovered, found as expressed below:

NOTE: Not more than 2 corners, all in the same town and range, may be recorded on this certificate.

	A	B	C	D	E	F	G	H	I	J	K	L	M
1													
2		6		5		4		3		2		1	
3													
4		7		8		9		10		11		12	
5													
6		18		17		16		15		14		13	
7													
8		19		20		21		22		23		24	
9													
10		30		29		28		27		26		25	
11													
12		31		32		33		34		35		36	
13													

A. Description of original monument and accessories and/or subsequent restoration:

M-12 1838 G.L.O. SURVEY BY J. BRINK WOOD POST IRONWOOD 7 N28 1/2W 38 BEECH 10 S18 1/2W 12

B. Description of corner evidence found and/or method applied in restoring or reestablishing corner:


M-12 SET 5/8" X 36" IRON AND BRASS CAP BY SINGLE PROPORTIONATE MEASUREMENT BETWEEN THE SE CORNER OF SECTION 36 AND THE NE CORNER OF SECTION 24, T22N, R12W. THE CORNER FALLS ON NORTHERLY HILLSIDE AND 120' WEST OF OLD TRAIL ROAD. THIS CORNER IS ACCEPTED AS A CAREFUL AND FAITHFUL RE-ESTABLISHMENT OF THE POSITION OF THE ORIGINAL CORNER.

C. Description of monument for corner and accessories established to perpetuate locating the position of the corner:

M-12 1/4 CORNER COMMON TO SECTION 36, T22N, R12W & SECTION 31, T22N, R11W
5/8" X 36" IRON & BRASS CAP STAMPED: CJP, 39095, 1998, 1/4, 36, 31

N11°E	14" BEECH	15.74'
N79°E	7" MAPLE	7.99'
S42°W	9" MAPLE	17.02'
N73°W	8" TWIN MAPLE	16.88'

Peer Group Reviewed and Approved
Date: Dec 98
Richard D. Wilcox
Richard D. Wilcox, Wexford County Surveyor

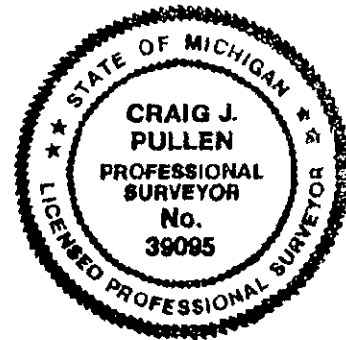

Signed by *Craig J. Pullen* Date December 3, 1998

Surveyor's Michigan License No. 39095 FORM APPROVED BY MICHIGAN STATE BOARD OF PROFESSIONAL SURVEYORS, JAN. 28, 1971