

JAN 17 1996

RECEIVED

1995 DEC 14 PM 3:50

COMMISSION LAND CORNER RECORDATION CERTIFICATE

Filing Requirement of Act 74, Mich. P.A. 1970

For corners in Wexford (County)

Located In:

Corner Code #

- 1. Public Land Survey T 22N R 11W M-3
2. Property Controlling in Section S T R
3. Miscellaneous Property in Section S T R

WEXFORD COUNTY, MI. REGISTER OF DEEDS

Register of Deeds Stamp & File Number

- 4. Lot No. , Recorded Plat.
5. Private Claims

Grid table with columns A-M and rows 1-13. Cell (2,6) contains '6', (2,7) contains '5', (2,8) contains '4', (2,9) contains '3', (2,10) contains '2', (2,11) contains '1'.

I, George D. Smith, in a field survey on October 23, 1995, do hereby certify that under requirements of P.A. 74, Michigan P.A. of 1970, the corner points mentioned in lines 1 and 2 above were in conformance with regulations and rules therefore as required in the current manual of survey instructions of the United States Department of the Interior, Bureau of Land Management or by a decree of a Court of Law and/or that the corner points mentioned in lines 3, 4 and 5 above were in conformance with the rules of the Michigan Board of Professional Surveyors or by a Decree of a Court of Law; established, re-established, monumented, re-monumented, recovered, found as expressed below:

NOTE: Not more than 4 corners, all in the same town and range, may be recorded on this certificate.

A. Description of original monument and accessories and/or subsequent restoration:

- 1837 GLO Section post by John Brink, Deputy Surveyor, Beech 11 S 26° W 48, Beech 11 N 15 1/2° W 28.
1852 GLO Subdivision of Section 6 & 7, T22N, R10W by L.S. Scranton, Deputy Surveyor, Sugar 18 S 75° E 18', Beech N 47° E 64'
1893 Devoe Survey for petition in Section 6, T22N, R10W, Liber 1, Page 175 corner found no description given, Pine S 40° W 37', Sugar 22, N 36 1/2° W 1.04
1949 MSHD, Project 82-83, Fd. cast iron bed post and wood stake 10" Beech N 19° W 98.56' 14" Maple S 23° E 161.00', 8" TW. Elm S 46° W 58.33'
1962 W.C.R.C. Cast iron bed post S 23° E 161.00' 14" Maple, S 46° W 58.33' 8" Elm N 19° W 98.53 10" Beech.
1966 U.S.F.S. index card, Griffin found cast iron bed post. Witnesses same as 1962 WCRC

B. Description of corner evidence found and/or method applied in restoring or reestablishing corner:


Found cast iron bed post and 1 witness from 1949 MSHD Survey. Location also matches closely with 1893 Devoe distance to North. This corner is accepted as the best available evidence of position of the original corner, being the section corner common to Section 1 and 12, T22N-R11W and Sections 6 and 7, T22N-R10W.

Peer Group Reviewed and Approved

Date: Dec 45
Richard D. Wilcox, Wexford County Surveyor

C. Description of monument for corner and accessories established to perpetuate locating the position of the corner:

- Replaced cast iron bed post with 5/8" x 36" iron with Wexford County brass cap stamped: SE 1, 1995, PS 39098
S 65°E 87.08' Power Pole
S 36° W 37.61' Power Pole
S 67°W 63.58' 3" Poplar
N 15°W 98.49' 18" Beech (MSHD wit)

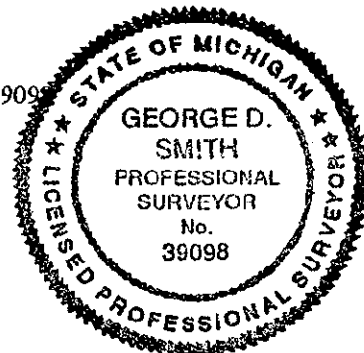

Signed by George D. Smith
Surveyor's Michigan License No. 39098

Date 12-8-95