

JAN 17 1996

RECEIVED

COMMISSION

LAND CORNER RECORDATION CERTIFICATE
Filing Requirement of Act 74, Mich. P.A. 1970

1995 DEC 13 AM 11:42

For corners in
WEXFORD

Linda Loughmiller
WEXFORD COUNTY, MI
REGISTER OF DEEDS

(County)	Located In:	Corner Code #
1. Public Land Survey	T <u>22N</u> R <u>11W</u>	<u>M-7</u>
	T _____ R _____	_____
	T _____ R _____	_____
	T _____ R _____	_____
2. Property Controlling in Section	S _____ T _____ R _____	_____
	S _____ T _____ R _____	_____
3. Miscellaneous Property in Sec.	S _____ T _____ R _____	_____
	S _____ T _____ R _____	_____

Register of Deeds Stamp & File Number

- 4. Lot No. _____, Recorded Plat _____
- 5. Private Claims _____

	A	B	C	D	E	F	G	H	I	J	K	L	M
2	6		5		4		3		2		1		
3													
4	7		8		9		10		11		12		
5													
6	18		17		16		15		14		13		
7													
8	19		20		21		22		23		24		
9													
10	30		29		28		27		26		25		
11													
12	31		32		33		34		35		36		
13													

I, CRAIG J. PULLEN, in a field survey on OCTOBER 31, 1995, do hereby certify that under requirements of P.A. 74, Michigan P.A. of 1970, the corner points mentioned in lines 1 and 2 above were in conformance with regulations and rules therefore as required in the current manual of survey instructions of the United States Department of the Interior, Bureau of Land Management or by a decree of a Court of Law and/or that the corner points mentioned in lines 3, 4 and 5 above were in conformance with the rules of the Michigan Board of Land Surveyors or by a Decree of a Court of Law; established, re-established, monumented, re-monumented, recovered, found as expressed below:

NOTE: Not more than 4 corners, all in the same town and range, may be recorded on this certificate.

A. Description of original monument and accessories and/or subsequent restoration:

- M-7 1837 ORIGINAL GOVERNMENT SURVEY BY J. BRINK WOOD POST BEECH 8 S13W 23 BEECH 13 N47½W 34
 - 1900 A.J. TEED SURVEY IN SECTION 24, T22N, R11W CORNER SHOWN AS IN NO CORNER DESCRIPTION OR WITNESSES GIVEN.
 - 1913 E.E. SOURS SURVEY IN SEC.18, T22N, R10W FOUND WOODEN STAKE FENCE POST S47W 34½ FENCE POST N48½E 42½
- WEXFORD COUNTY ROAD COMMISSION MONUMENT BOX NO WITNESSES GIVEN

B. Description of corner evidence found and/or method applied in restoring or reestablishing corner:


- M-7 FOUND ½" PIPE IN MONUMENT BOX IN CENTERLINE OF 32 ROAD AND 2' WEST OF CENTERLINE OF 25 ROAD. REPLACED PIPE WITH 5/8" X 36" IRON AND BRASS CAP. THIS CORNER IS ACCEPTED AS THE BEST AVAILABLE EVIDENCE OF THE POSITION OF THE ORIGINAL CORNER.

Peer Group Reviewed and Approved

Date: 8 Dec. 95
Richard D. Wilcox
Richard D. Wilcox, Wexford County Surveyor

C. Description of monument for corner and accessories established to perpetuate locating the position of the corner:

- M-7 SECTION CORNER COMMON TO SECTIONS 13 AND 24, T22N, R11W AND SECTIONS 18 AND 19, T22N, R10W
- 5/8" X 36" IRON AND BRASS CAP STAMPED: CJP, 39095, 24, 13, 18, 19, 1995
- S45°W GUY POLE 42.69'
- N45°W POWER POLE 42.10'
- N27°W 10" RED PINE 98.16'
- S28°E 3" CHERRY 103.37'

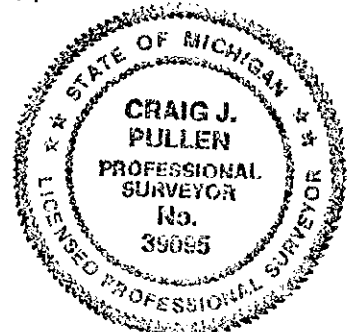

DECEMBER 6, 1995

Signed by *Craig J. Pullen* Date _____
Surveyor's Michigan License No. 39095