

JAN 17 1996

RECEIVED

LAND CORNER RECORDATION CERTIFICATE
Filing Requirement of Act 74, Mich. P.A. 1970

1995 DEC 13 AM 11:42

COMMISSION

For corners in
WEXFORD

Linda Loughmiller
WEXFORD COUNTY, MI
REGISTER OF DEEDS

(County)	Located In:	Corner Code #
1. Public Land Survey	T <u>22N</u> R <u>11W</u>	<u>M-8</u>
	T _____ R _____	_____
	T _____ R _____	_____
	T _____ R _____	_____
2. Property Controlling in Section	S _____ T _____ R _____	_____
	S _____ T _____ R _____	_____
3. Miscellaneous Property in Sec.	S _____ T _____ R _____	_____
	S _____ T _____ R _____	_____

Register of Deeds Stamp & File Number

4. Lot No. _____, Recorded Plat _____
5. Private Claims _____

	A	B	C	D	E	F	G	H	I	J	K	L	M
2	6	5	4	3	2	1							
3													
4	7	8	9	10	11	12							
5													
6	18	17	16	15	14	13							
7													
8	19	20	21	22	23	24							
9													
10	30	29	28	27	26	25							
11													
12	31	32	33	34	35	36							

I, CRAIG J. PULLEN, in a field survey on OCTOBER 31, 1995, do hereby certify that under requirements of P.A. 74, Michigan P.A. of 1970, the corner points mentioned in lines 1 and 2 above were in conformance with regulations and rules therefore as required in the current manual of survey instructions of the United States Department of the Interior, Bureau of Land Management or by a decree of a Court of Law and/or that the corner points mentioned in lines 3, 4 and 5 above were in conformance with the rules of the Michigan Board of Land Surveyors or by a Decree of a Court of Law; established, re-established, monumented, re-monumented, recovered, found as expressed below:

NOTE: Not more than 4 corners, all in the same town and range, may be recorded on this certificate.

A. Description of original monument and accessories and/or subsequent restoration:

- M-8 1837 ORIGINAL GOVERNMENT SURVEY BY J. BRINK WOOD POST BEECH 10 N82½W 30 BEECH 12 S48W 4 1900 A.J. TEED SURVEY IN SEC.24, T22N, R11W CORNER SHOWN AS IN ON SHEET NO CORNER DESC. OR WITNESSES GIVEN.
- 1978 J.L. WILCOX & ASSOC. SURVEY L.1, P.618 AND L.C.R.C. L.3, P.177 BY J.L. WILCOX, PS #14102 SET WEXFORD COUNTY MONUMENT BY S.P. N40°E 18" DBL. MAPLE 19.26' N65°W 5" MAPLE 36.53' S75°E 3" MAPLE IN CLUMP 20.92'
- 1981 NORTHWESTERN SURVEYING & MAPPING SURVEY L.1, P.870 BY J. MILLETICS, PS #25859 N80°W 19.25' 40" MAPLE N30°E 36.50' 18" MAPLE S80°E 20.9' TRIPLE MAPLE
- 1988 J.L. WILCOX & ASSOC. SURVEY L.66, P.510 BY J.L. WILCOX, PS #14102 FOUND WEXFORD COUNTY MONUMENT WITNESSES SAME AS 1978 L.3, P.177.

B. Description of corner evidence found and/or method applied in restoring or reestablishing corner:


M-8 FOUND WEXFORD COUNTY MONUMENT IN POOR CONDITION 4' WEST OF CENTERLINE 25 ROAD. REPLACED WITH 5/8" X 36" IRON AND BRASS CAP. THIS CORNER IS ACCEPTED AS A CAREFUL AND FAITHFUL REESTABLISHMENT OF THE POSITION OF THE ORIGINAL CORNER.

Peer Group Reviewed and Approved

Date: 22 Nov 95
Richard D. Wilcox
Richard D. Wilcox, Wexford County Surveyor

C. Description of monument for corner and accessories established to perpetuate locating the position of the corner:

M-8 ¼ CORNER COMMON TO SECTION 24, T22N, R11W AND SECTION 19, T22N, R10W
5/8" X 36" IRON AND BRASS CAP STAMPED: CJP, 39095, 1995, ¼, 24, 19
N59°W 24" TWIN MAPLE 20.14'
S25°W 12" MAPLE 50.30'
N82°E 10" TRIPLE MAPLE 28.92'
N42°E 15" MAPLE 58.76'

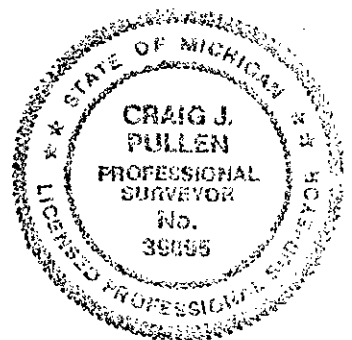

Signed by Craig J. Pullen Date NOVEMBER 9, 1995
Surveyor's Michigan License No. 39095