

JAN 17 1996

COMMISSION

LAND CORNER RECORDATION CERTIFICATE
Filing Requirement of Act 74, Mich. P.A. 1970

RECEIVED

1995 DEC 13 AM 11:42

Linda Loughmiller
WEXFORD COUNTY, MI
REGISTER OF DEEDS

For corners in
WEXFORD

(County)

Located In:

Corner Code #

1. Public Land Survey	T	22N	R	11W	M-11
	T		R		
	T		R		
	T		R		
2. Property Controlling in Section	S		T	R	
	S		T	R	
3. Miscellaneous Property in Sec.	S		T	R	
	S		T	R	

Register of Deeds Stamp & File Number

4. Lot No. _____, Recorded Plat _____
5. Private Claims _____

A	B	C	D	E	F	G	H	I	J	K	L	M
2	6		5		4		3		2		1	
3												
4	7		8		9		10		11		12	
5												
6	18		17		16		15		14		13	
7												
8	19		20		21		22		23		24	
9												
10	30		29		28		27		26		25	
11												
12	31		32		33		34		35		36	
13												

I, CRAIG J. PULLEN, in a field survey on OCTOBER 31, 1995, do hereby certify that under requirements of P.A. 74, Michigan P.A. of 1970, the corner points mentioned in lines 1 and 2 above were in conformance with regulations and rules therefore as required in the current manual of survey instructions of the United States Department of the Interior, Bureau of Land Management or by a decree of a Court of Law and/or that the corner points mentioned in lines 3, 4 and 5 above were in conformance with the rules of the Michigan Board of Land Surveyors or by a Decree of a Court of Law; established, re-established, monumented, re-monumented, recovered, found as expressed below:

NOTE: Not more than 4 corners, all in the same town and range, may be recorded on this certificate.

A. Description of original monument and accessories and/or subsequent restoration:

- M-11 1837 ORIGINAL GOVERNMENT SURVEY BY J. BRINK SUGAR 8 S48W 21 SUGAR 11 N58½W 34
- 1901 H.J. DEVOE SURVEY IN SEC.30, T22N, R10W POST IN CENTER OF HIGHWAY. ORIGINAL GOVERNMENT CORNER WITH STONE & CROCKERY AROUND POST.
- 1969 WEXFORD COUNTY ROAD COMMISSION BOOK AXLE SHAFT 15" DEEP TW. ASPEN N80°W 83.20' P.P. N45°W 48.50' F.P. (PRIVATE) N85°E 33.10' S. END OF 15" CULVERT ON E. OF ROAD S50°E 29.30'
- 1988 J.L. WILCOX & ASSOC. SURVEY BY D. SCHRIPSEMA, PS #24617 FOUND AXLE SHAFT N40°W 50.62' COR. FE. POST N55°W 68.49' 6" W. CHERRY EAST 33.25' FE. POST S44°W 46.62' R.O.W. IRON

B. Description of corner evidence found and/or method applied in restoring or reestablishing corner:


M-11 FOUND AXLE SHAFT 1.3' EAST OF CENTERLINE OF 25 ROAD AND 6' NORTH OF CENTERLINE 36 ROAD 15" DOWN, AND TWO PREVIOUS WITNESSES. SET 5/8" X 36" IRON AND BRASS CAP IN AXLE SHAFT. THIS CORNER IS ACCEPTED AS THE BEST AVAILABLE EVIDENCE OF THE POSITION OF THE ORIGINAL CORNER.

Peer Group Reviewed and Approved

Date: 22 Nov 95
Richard D. Wilcox
Richard D. Wilcox, Wexford County Surveyor

C. Description of monument for corner and accessories established to perpetuate locating the position of the corner:

- M-11 SECTION CORNER COMMON TO SECTIONS 25 AND 36, T22N, R11W AND SECTIONS 30 AND 31, T22N, R10W
- 5/8" X 36" IRON AND BRASS CAP STAMPED: CJP, 39095, 1995, 25, 36, 30, 31
- N42°W 4" POPLAR 54.56'
- N55°W 7" CHERRY 68.49'
- EAST FENCE POST 33.25'
- S28°E TOP CENTER OF PHONE PEDESTAL 54.49'

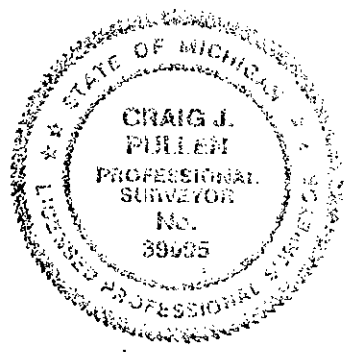

Signed by Craig J. Pullen Date NOVEMBER 9, 1995
Surveyor's Michigan License No. 39095