

LAND CORNER RECORDATION CERTIFICATE

FILING REQUIREMENT OF ACT 74, MICH. P.A.1970

FOR CORNERS OF--:	LOCATED IN--:	CORNER CODE NUMBER
1. PUBLIC LAND SURVEY _____	T. <u>23</u> N. <u>9</u> R. <u>W.</u>	<u>M-12, M13</u>
2. PROPERTY CONTROLLING IN SECTION <u>36</u>	T. <u>23</u> N. <u>9</u> R. <u>W.</u>	<u>Code 14</u>
3. MISCELLANEOUS PROPERTY IN SECTION _____	T. _____ N. _____ R. <u>W.</u>	_____
4. LOT NO. _____, RECORDED PLAT _____		
5. PRIVATE CLAIMS _____		

REGISTER OF DEEDS STAMP AND FILING NUMBER

I, Carl F. Roser do hereby certify that under requirements of P.A. 74, Michigan P.A. of 1970, the corner points mentioned in lines 1 and 2 above (identified with circles on index code diagram - over) were, in a field survey on 10-31 19 , established, re-established, monumented, re-monumented, recovered or restored as expressed below and in conformance with regulations and rules therefore as required in the current manual of survey instructions of the United States Department of the Interior, Bureau of Land Management or by a decree of a court of law. Furthermore, that the corner points mentioned in lines 3, 4 and 5 above were, in a field survey on _____ 19 , found, recovered, restored, established or re-established as expressed below and in conformance with the rules of the Michigan State Board of Registration for Land Surveyors or, by a Decree of a Court of law:

A. Description of original monument and accessories and/or subsequent restoration:


- M-12 B. Description of corner evidence found and/or method applied in restoring or re-establishing corner:
Recovered corner - found stake shadow from probable U.S.B.T. (stump) Y.Pine 16" S70W 11.9'. Computed position by single proportion would be 2.7' N and 5.2' W. Accepted stake shadow.
- M-13 Remonumented and re-witnesses previous Department Corner of Record. Dept. Mon. had been removed by unknown persons.
- 14 Established corner per standard B.L.M. instructions.

C. Description of monument for corner and accessories established to perpetuate locating the position of the corner:

M-12	M-13	14
Set 1 1/4" x 9' pipe & Cedar Gd. Post w/loc tag.	Set 1 1/4" x 9' pipe & Cedar Gd. Post w/loc tag	Set 1 1/4" x 9' pipe & Cedar Gd. Post w/loc tag
18" W.Pine S65W 59.2'	7" Cedar N59E 30.1'	8" Cedar N72W 4.2'
18" W.Pine N65W 45.6'	6" Cedar S48E 36.3'	10" Cedar S86E 13.9'
12" W. Pine N50W 58.9'	7" Cedar S38W 24.1'	9" Cedar S 9W 15.0'
Ctr.dirt Trail	8" Cedar N10W 19.9'	N-S Rand. Due W 31'
Rd.(on curve) N50E 37'	7" Dead Spruce S40E 15.2'	

SIGNED BY Carl F. Roser DATE 1-11-73
 SURVEYOR'S MICHIGAN REGISTRATION NO. 12028

FOR STATE AND UNITED STATES AGENCIES:
 SIGNED BY _____ DATE _____
CHIEF OF SURVEY PARTY
 APPROVED AND SIGNED BY _____ DATE _____
MICHIGAN REGISTERED LAND SURVEYOR

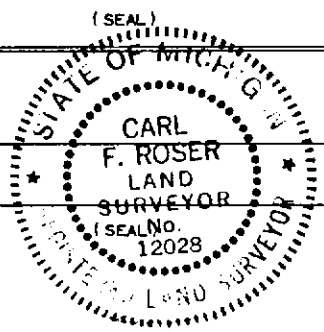

SURVEYOR'S MICHIGAN REGISTRATION NO. _____