

# LAND CORNER RECORDATION CERTIFICATE

FILING REQUIREMENT OF ACT 74, MICH. P.A. 1970

FOR CORNERS OF--:	LOCATED IN--:	CORNER CODE NUMBER
1. PUBLIC LAND SURVEY _____	T. <u>23</u> N. S., R. <u>9</u> E. W.	M-7 M-8
2. PROPERTY CONTROLLING IN SECTION _____	, T. _____ N. S., R. _____ E. W.	
3. MISCELLANEOUS PROPERTY IN SECTION <u>24</u>	, T. <u>23</u> N. S., R. <u>9</u> E. W.	653.2' S. of M-8 1959.6' N of M-9
4. LOT NO. _____	RECORDED PLAT _____	
5. PRIVATE CLAIMS _____		

REGISTER OF DEEDS STAMP AND FILING NUMBER

I, Carl F. Roser do hereby certify that under requirements of P.A. 74, Michigan P.A. of 1970, the corner points mentioned in lines 1 and 2 above (identified with circles on index code diagram—over) were, in a field survey on 11-27 1972, established, re-established, monumented, re-monumented, recovered or restored as expressed below and in conformance with regulations and rules therefore as required in the current manual of survey instructions of the United States Department of the Interior, Bureau of Land Management or by a decree of a court of law. Furthermore, that the corner points mentioned in lines 3, 4 and 5 above were, in a field survey on 11-27 1972, found, recovered, restored, established or re-established as expressed below and in conformance with the rules of the Michigan State Board of Registration for Land Surveyors or, by a Decree of a Court of law:

A. Description of original monument and accessories and/or subsequent restoration:

B. Description of corner evidence found and/or method applied in restoring or re-establishing corner:

- M-7 Accepted 1/2" iron as recovered by Wilcox & Erickson
- M-8 Restored corner in center of N-S dirt road (old Twp Rd. with ROW fences) in line with fence remains E & W.
- ITEM 3 Established NW corner of S1/2-N1/2-SW1/4 of Sec. 19, T23N-R8W, per Standard B.L.M. instructions.

C. Description of monument for corner and accessories established to perpetuate locating the position of the corner:

M-7	M-8	ITEM 3
Found 1/2" iron in center of road intersection N-S-E-W	Set DNR Monument	Set 1"x36" pipe in center of N-S dirt road.
Tel. Pole N37W 39.5'	26" Maple S13E 64.10'	12" Maple N22E 65.3'
	8" Cherry N21E 73.30'	12" R. Pine S72W 68.5'
	5" Cherry S76E 69.40'	10" R. Pine S17W 138.1'
	Set loc. tag on fence post N80E 25'	Set Ced post w/loc tag Due W 16.5'


SIGNED BY Carl F. Roser DATE 1-11-73

SURVEYOR'S MICHIGAN REGISTRATION NO. 12028

FOR STATE AND UNITED STATES AGENCIES:

SIGNED BY \_\_\_\_\_ DATE \_\_\_\_\_  
CHIEF OF SURVEY PARTY

APPROVED AND SIGNED BY \_\_\_\_\_ DATE \_\_\_\_\_  
MICHIGAN REGISTERED LAND SURVEYOR

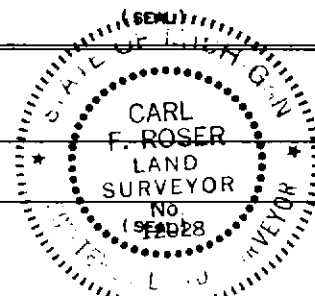

SURVEYOR'S MICHIGAN REGISTRATION NO. \_\_\_\_\_