

SECTION

1998 DEC 30 1998

RECEIVED

1998 DEC 30 PM 2: 12

LAND CORNER RECORDATION CERTIFICATE  
Filing Requirement of Act 74, Mich. P.A. 1970

*Linda Longmiller*  
WEXFORD COUNTY, MI  
REGISTER OF DEEDS

For corners in

Wexford Located in: Corner Code #  
(County)  
1. Public Land Survey T 23N R 10W M-8

2. Property Controlling S  
in Section S  
3. Miscellaneous S  
Property in Sec. S

*Common to;*

*A-8 T23N, R9W*

Register of Deeds Stamp & File Number

4. Lot No. \_\_\_\_\_, Recorded Plat \_\_\_\_\_  
5. Private Claims \_\_\_\_\_

	A	B	C	D	E	F	G	H	I	J	K	L	M
1													
2		6		5		4		3		2			1
3													
4		7		8		9		10		11			12
5													
6		18		17		16		15		14			13
7													
8		19		20		21		22		23			24
9													
10		30		29		28		27		26			25
11													
12		31		32		33		34		35			36
13													

I, George D. Smith, P.S., in a field survey on Nov. 11, 19 98 do hereby state that under requirements of P.A. 74, Michigan P.A. of 1970, the corner points mentioned in lines 1 and 2 above were in conformance with regulations and rules therefore as required in the current manual of survey instructions of the United States Department of the Interior, Bureau of Land Management or by a decree of a Court of Law and /or that the corner points mentioned in lines 3, 4 and 5 above were in conformance with the rules of the Michigan Board of Land Surveyors or by a Decree of a Court of Law; established, re-established, monumented, recovered, found as expressed below:

NOTE: Not more than 2 corners, all in the same town and range, may be recorded on this certificate.

A. Description of original monument and accessories and/or subsequent restoration:

- M-8) 1838 GLO Quarter Section Post by John Brink, Deputy Surveyor; Maple 6-577 1/2 W-40; Maple 10-S69 1/2 W-41
- M-8) 1977 J.L. Wilcox, PS# 14102, Certificate of Survey Liber 1, Page 540. Set Wexford Co. Mon. West-12" poplar 12.0, S60W 8" Cherry 31.28, N55W, 8" poplar 35.83
- M-8) 1977 J.L. Wilcox, PS# 14102, Certificate of Survey Liber 1, Page 610. Set Wexford Co. Mon.
- M-8) 1977 J.L. Wilcox, PS# 14102, LCRC Liber 3, Page 141. Set Wexford Co. Mon. Witness same as 1977 Cert. of Survey
- M-8) 1993 D. Geers, PS# 33977, Cert. of Survey Liber 72, Page 485. Found Wexford Co. Mon. witnesses same as 1977 Wilcox PS 14102 LCRC.

B. Description of corner evidence found and/or method applied in restoring or reestablishing corner:

Found Wexford Co. Mon. and 2 witnesses from 1977 Wilcox PS# 14102 LCRC. This corner is accepted as a careful and faithful re-establishment of the position of the original corner being the quarter corner common to Section 24 T23N-R10W and Section 19 T23N-R9W.


C. Description of monument for corner and accessories established to perpetuate locating the position of the corner:

Wexford Co. Mon. stamped PS 39098, 1998, E 1/4 24.  
S60W 11.95' 12" poplar (Wilcox 12.00')  
N55W 38.89' 8" Cherry (Wilcox 31.28')  
S70W 88.64' 8" Red Pine  
South 47.99' 5" Cherry

Peer Group Reviewed and Approved

Date: 12-9-98  
*Richard D. Wilcox*  
Richard D. Wilcox, Wexford County Surveyor

Signed by *George D. Smith*  
Surveyor's Michigan License No. 39098

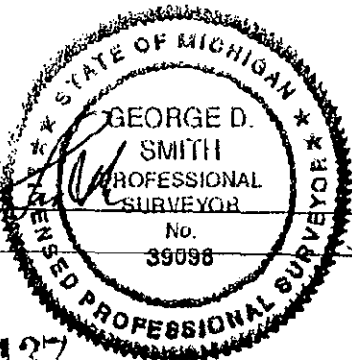

Date 12-9-98