

APR 15 1998

RECEIVED

1998 DEC 30 PM 2: 12

SECTION

LAND CORNER RECORDATION CERTIFICATE
Filing Requirement of Act 74, Mich. P.A. 1970

Linda Loughmiller
WEXFORD COUNTY, MI
REGISTER OF DEEDS

For corners in

Wexford
(County)

Located In: Corner Code #

1. Public Land Survey T 23N R 10W M-9

Common to:

- 2. Property Controlling in Section S_
- 3. Miscellaneous S_
- Property in Sec. S_

A-9 T23N, R9W ✓

Register of Deeds Stamp & File Number

- 4. Lot No. _____, Recorded Plat _____
- 5. Private Claims _____

	A	B	C	D	E	F	G	H	I	J	K	L	M
1													
2	6			5		4		3		2			1
3													
4	7			8		9		10		11			12
5													
6	18			17		16		15		14			13
7													
8	19			20		21		22		23			24
9													
10	30			29		28		27		26			25
11													
12	31			32		33		34		35			36
13													

I, George D. Smith, P.S., in a field survey on April 29, 19 98 do hereby state that under requirements of P.A. 74, Michigan P.A. of 1970, the corner points mentioned in lines 1 and 2 above were in conformance with regulations and rules therefore as required in the current manual of survey instructions of the United States Department of the Interior, Bureau of Land Management or by a decree of a Court of Law and/or that the corner points mentioned in lines 3, 4 and 5 above were in conformance with the rules of the Michigan Board of Land Surveyors or by a Decree of a Court of Law; established, re-established, monumented, recovered, found as expressed below:

NOTE: Not more than 2 corners, all in the same town and range, may be recorded on this certificate.

A. Description of original monument and accessories and/or subsequent restoration:

- M-9) 1838 GLO Section Post by John Brink, Deputy Surveyor; Sugar 12-S56 1/2 W-28; Hemlock 8-N53W-14
- M-9) 1853 GLO Subdivision of T23N-R9W by V.W. Calkin, Deputy Surveyor; Sugar 12-S16E-44; Sugar 8-N34E-21.
- M-9) 1914 D. Teed Survey, Liber 1, Page 259 and 274. Corner found no desc. given. Sugar 18-N60E-13.7'; Sugar-S72E-32.5'
- M-9) 1977 Wilcox, PS 14102, Cert. of Survey Liber 1, Page 540 and 610. Found 1 1/2" x 24" pipe replaced with Wexford Co. Mon. N75E-10" Maple-24.63; N45W-10" Maple-10.42'; South-8" Maple-5.61'; S45E-8" Cherry-7.60
- M-9) 1977 J.L. Wilcox PS 14102 LCRC, Liber 1, Page 141. Replaced 1 1/2"x24" pipe with Wexford Co. Mon. witness same as 1977 Wilcox PS 14102 Cert. of Survey.
- M-9) 1985 Mitchell PS# 28417 Cert. of Survey Liber 2, Pages 133-138. Found monument witnesses same as 1977 Wilcox PS # 14102 Cert. of Survey

B. Description of corner evidence found and/or method applied in restoring or reestablishing corner:


Found Wexford Co. Mon and 2 witnesses from 1977 Wilcox PS# 14102 LCRC. This corner is accepted as the best available evidence of the position of the original corner being the section corner common to Sections 24 and 25, T23N-R10W and Sections 19 and 30, T23N-R9W.

C. Description of monument for corner and accessories established to perpetuate locating the position of the corner:

- Wexford Co. Mon. stamped PS 39098, 1998, SE 24.
- N75E 24.63' 12" Maple (Wilcox 24.63')
- N45W 13.42' 12" Maple
- South 5.61' 10" Maple (Wilcox 5.61')
- S55E 7.42' 16" Cherry

Peer Group Reviewed and Approved
Date: 7 December 1998
Richard D. Wilcox
Richard D. Wilcox, Wexford County Surveyor

Signed by *George D. Smith*
Surveyor's Michigan License No. 39098

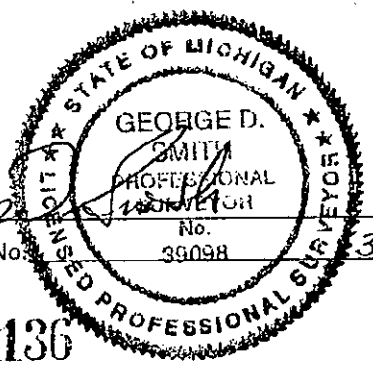

Date 12-9-98