

**LAND CORNER RECORDATION CERTIFICATE**  
**Filing Requirement of Act 74, Mich. P.A. 1970**

For corners in  
**WEXFORD**

(County)

Located In:

Corner Code #

- |                                      |   |     |   |    |      |
|--------------------------------------|---|-----|---|----|------|
| 1. Public Land Survey                | T | 23N | R | 9W | B-13 |
|                                      | T |     | R |    |      |
|                                      | T |     | R |    |      |
|                                      | T |     | R |    |      |
| 2. Property Controlling in Section   | S |     | T |    |      |
|                                      | S |     | T |    |      |
| 3. Miscellaneous Property in Section | S |     | T |    |      |
|                                      | S |     | T |    |      |
4. Lot No. \_\_\_\_\_, Recorded Plat \_\_\_\_\_
5. Private Claims \_\_\_\_\_

**RECEIVED**  
 1996 OCT -9 PM 3:26  
*Linda Loughmiller*  
 WEXFORD COUNTY, MI  
 REGISTER OF DEEDS  
 Register of Deeds Stamp & File Number

A	B	C	D	E	F	G	H	I	J	K	L	M
2	6		5		4		3		2			
3												
4	7		8		9		10		11		12	
5												
6	13		17		16		15		14		13	
7												
8	19		20		21		22		23		24	
9												
10	30		29		28		27		26		25	
11												
12	31		32		33		34		35		36	
13												

I, CRAIG J. PULLEN, in a field survey on MAY 31, 1996, do hereby certify that under requirements of P.A. 74, Michigan P.A. of 1970, the corner points mentioned in lines 1 and 2 above were in conformance with regulations and rules therefore as required in the current manual of survey instructions of the United States Department of the Interior, Bureau of Land Management or by a decree of a Court of Law and/or that the corner points mentioned in lines 3, 4 and 5 above were in conformance with the rules of the Michigan Board of Professional Surveyors or by a Decree of a Court of Law; established, re-established, monumented, re-monumented, recovered, found as expressed below:

**NOTE: Not more than 4 corners, all in the same town and range, may be recorded on this certificate.**

**A. Description of original monument and accessories and/or subsequent restoration:**

- B-13 1838 ORIGINAL GLO SURVEY BY J. BRINK WOOD POST BEECH 7 N46E 13 BEECH 8 N30½W 25  
 1883 A.J. TEED SURVEY IN SEC.31, T23N, R9W HEM 14 N57½W 14 W. PINE 14 N23E 15  
 1907 D.E. TEED SURVEY IN SEC.6, T22N, R9W SET CORNER PRORATED TO U.S. SURVEY BETWEEN SECTION CORNERS EAST AND WEST. W. PINE 30 N42W 19½ W. PINE 18 N27½W 38 W. PINE 24 S24E 55½  
 1985 R. MITCHELL, PS #28417 L.C.R.C. L. 3, P. 347 SET WEXFORD COUNTY MONUMENT FROM THE REMAINS OF D.E. TEED WITNESSES FROM 1907 SURVEY. THIS POSITION FALLS 1.5' NORTH OF A LARGE GRANITE STONE AND ON THE REMAINS OF AN OLD FENCE LINE WEST S47°E 4" OAK 17.10' S22°E 5" OAK 13.50' WEST 3" MAPLE 12.95' N3°E 2" MAPLE 7.32'  
 1988 J. TAYLOR, PS #32342 SURVEY IN SEC.6, T22N, R9W L. 67, P. 629 FOUND ALUM. CAP. 5" OAK S45°E 17.1' 6" OAK S20°E 13.5' 4" MAPLE WEST 18.9' 4" MAPLE NORTH 7.3'

**B. Description of corner evidence found and/or method applied in restoring or reestablishing corner:**

B-13 FOUND WEXFORD COUNTY MONUMENT IN EXCELLENT CONDITION 1.5' NORTH OF LARGE GRANITE STONE. THIS CORNER IS ACCEPTED AS A CAREFUL AND FAITHFUL REESTABLISHMENT OF THE POSITION OF THE ORIGINAL CORNER.


SURVEY &  
 RE-MONUMENTATION

MAY 20 1997

Peer Group Reviewed and Approved.  
 Date: 26 Sep 96  
Richard D. Wilcox  
 Richard D. Wilcox, Wexford County Surveyor

**C. Description of monument for corner and accessories established to perpetuate locating the position of the corner:**

- B-13 S¼ CORNER, SECTION 31, T23N, R9W  
 WEXFORD COUNTY MONUMENT  
 S45°E 5" OAK 17.12'  
 S20°E 6" OAK 13.46'  
 N2°W 4" OAK 17.53'  
 N81°W 4" OAK 19.04'

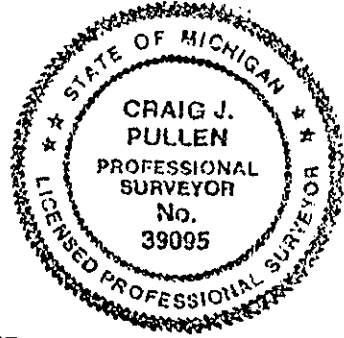

Signed by Craig J. Pullen Date SEPTEMBER 9, 1996  
 Surveyor's Michigan License No. 39095