

LAND CORNER RECORDATION CERTIFICATE
Filing Requirement of Act 74, Mich. P.A. 1970

RECEIVED

For corners in
WEXFORD

(County)

Located In:

Corner Code #

1996 OCT -9 PM 3: 27

1. Public Land Survey	T	23N	R	9W	E-13
	T		R		
	T		R		
	T		R		
2. Property Controlling in Section	S		T	R	
	S		T	R	
3. Miscellaneous	S		T	R	
Property in Section	S		T	R	

Linda Loughmiller
 WEXFORD COUNTY, MI
 REGISTER OF DEEDS

Register of Deeds Stamp & File Number

4. Lot No. _____, Recorded Plat _____
 5. Private Claims _____

CRAIG J. PULLEN

MAY 31

96

I, _____, in a field survey on _____, 19_____, do hereby certify that under requirements of P.A. 74, Michigan P.A. of 1970, the corner points mentioned in lines 1 and 2 above were in conformance with regulations and rules therefore as required in the current manual of survey instructions of the United States Department of the Interior, Bureau of Land Management or by a decree of a Court of Law and/or that the corner points mentioned in lines 3, 4 and 5 above were in conformance with the rules of the Michigan Board of Professional Surveyors or by a Decree of a Court of Law; established, re-established, monumented, re-monumented, recovered, found as expressed below:

NOTE: Not more than 4 corners, all in the same town and range, may be recorded on this certificate.

A	B	C	D	E	F	G	H	I	J	K	L	M
2	6	5	4	3	2							
3												
4	7	8	9	10	11	12						
5												
6	18	17	16	15	14	13						
7												
8	19	20	21	22	23	24						
9												
10	30	29	28	27	26	25						
11												
12	31	32	33	34	35	36						
13												

A. Description of original monument and accessories and/or subsequent restoration:

- E-13 1838 ORIGINAL GLO SURVEY BY J. BRINK WOOD POST BEECH 11 N79E 41 BEECH 11 N10W 30
 1880 A.J. TEED SURVEY IN SEC.33, T23N, R9W CORNER SHOWN AS IN. NO WITNESSES GIVEN.
 1901 D.E. TEED SURVEY IN SEC.4, T22N, R9W FOUND STAKE SET BY A.J. TEED IN 1885 ALSO HIS WITS. W. PINE 22 S94W 80
 1961 MICH. DEPT. OF CONSERVATION SURVEY IN SEC.4, T22N, R9W, L.C.R.C. L2 P. 957 BY K. OSTLING, PS #10068. SET CORNER AT FENCE CORNER WHICH IS SUPPORTED BY THE REMAINS OF TEED'S SW WITNESS OF A 1901 SURVEY. FALLS WITHIN ONE FOOT OF LINE OVER 1/4 AND SECTION CORNER SOUTH, AND CHECKS TEED'S RECORD MEASUREMENTS, PROPORTIONATELY, TO 1/4 CORNERS SOUTH AND WEST. REMAINS OF A VERY OLD FENCE LINE FROM THIS CORNER AND RUNNING SOUTH VERY NEAR OUR LINE FOR SOME 200' BEFORE BECOMING OBLITERATED. TEED'S POST PROBABLY DESTROYED WHEN SETTING FENCE POST. CONSIDERED BEST AVAILABLE EVIDENCE OF PROPER LOCATION FOR CORNER 1" PIPE WITH 4" ALUMINUM CAP 16" W. PINE S35W 34.3' 6" MAPLE N55W 14.2'
 1993 GRAND TRAVERSE SURVEYING CO. SURVEY IN SEC.32, T23N, R9W L.72 P. 762 BY NEIL WAY, PS #28432 FOUND DEPT. OF CONSERVATION MON. OF RECORD.

B. Description of corner evidence found and/or method applied in restoring or reestablishing corner:

- E-13 FOUND 1" PIPE WITH ALUMINUM DNR CAP (BROKEN) IN EAST-WEST FENCE REMAINS AND SOUTH FENCE REMAINS AND 2 PREVIOUS WITNESSES. DROVE 5/8" X 36" IRON INSIDE PIPE AND ADDED BRASS CAP. THIS CORNER IS ACCEPTED AS A CAREFUL AND FAITHFUL PERPETUATION OF THE POSITION OF THE ORIGINAL CORNER.

SURVEY &
 REMONUMENTATION

MAY 20 1997

COMMISSION


Peer Group Reviewed and Approved

Date: 26 Sep 96

Richard D. Wilcox
 Richard D. Wilcox, Wexford County Surveyor

C. Description of monument for corner and accessories established to perpetuate locating the position of the corner:

- E-13 SECTION CORNER COMMON TO SECTIONS 32 AND 33, T23N, R9W, AND SECTIONS 4 & 5, T22N, R9W
 5/8" X 36" IRON AND BRASS CAP INSIDE 1" PIPE, CAP STAMPED: C 39095, 1996, 4, 5, 32, 33
 S35°W 20" WHITE PINE 34.30'
 N55°W 9" MAPLE IN CLUMP 14.36'
 N66°E 9" POPLAR 9.30'
 S5°E 4" WHITE PINE 9.97'

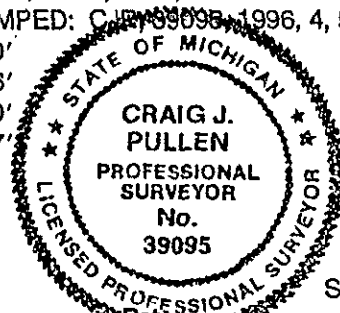

Signed by *Craig J. Pullen*

Surveyor's Michigan License No. 39095

SEPTEMBER 9, 1996