

**LAND CORNER RECORDATION CERTIFICATE**  
**Filing Requirement of Act 74, Mich. P.A. 1970**

For corners in Wexford (County) Located In: \_\_\_\_\_ Corner Code # \_\_\_\_\_

1. Public Land Survey	T	<u>23N</u>	R	<u>10W</u>	<u>C-13</u>
	T	_____	R	_____	_____
	T	_____	R	_____	_____
	T	_____	R	_____	_____
2. Property Controlling in Section	S	_____	T	_____	_____
	S	_____	T	_____	_____
3. Miscellaneous Property in Section	S	_____	T	_____	_____
	S	_____	T	_____	_____

**RECEIVED**  
 1996 DEC 13 PM 3:32  
**RECEIVED**  
 1996 DEC 13 PM 3:32  
*Linda Loughmiller*  
 WEXFORD COUNTY, MI  
 REGISTERED PROFESSIONAL SURVEYOR  
 WEXFORD COUNTY, MI  
 REGISTER OF DEEDS  
**Register of Deeds Stamp & File Number**

4. Lot No. \_\_\_\_\_, Recorded Plat \_\_\_\_\_  
 5. Private Claims \_\_\_\_\_

I, George D. Smith, in a field survey on July 23, 1996, do hereby certify that under requirements of P.A. 74, Michigan P.A. of 1970, the corner points mentioned in lines 1 and 2 above were in conformance with regulations and rules therefore as required in the current manual of survey instructions of the United States Department of the Interior, Bureau of Land Management or by a decree of a Court of Law and/or that the corner points mentioned in lines 3, 4 and 5 above were in conformance with the rules of the Michigan Board of Professional Surveyors or by a Decree of a Court of Law; established, re-established, monumented, re-monumented, recovered, found as expressed below:

A	B	C	D	E	F	G	H	I	J	K	L
2	6		5		4		3		2		1
3											
4	7		8		9		10		11		12
5											
6	18		17		16		15		14		13
7											
8	19		20		21		22		23		24
9											
10	30		29		28		27		26		25
11											
12	31		32		33		34		35		36
13											

**NOTE: Not more than 4 corners, all in the same town and range, may be recorded on this certificate.**

**A. Description of original monument and accessories and/or subsequent restoration:**

- C-13) 1837 GLO Quarter Section Post by John Brink, Deputy Surveyor, Sugar 8 N 45° E 17, Sugar N 27° W 27
- 1893 Devoc Survey, Liber 1, Page 175, found post with crockery and remains of two witness
- 1953 Survey by L. Dragoo RLS#3921, Corner found no description of corner given
- 1960 WCRC, Bk 40, Page 29, 27" Maple S 60° W 58.50', 24" Maple S 55° E 52.60', 15" Maple N 3° W 38.50
- 1968 Griffin RLS#13854, LCRC, Liber 1, Page 435, found 1 1/4" x 24" well point 6' South of intersection of roads East-West and south, replaced with 5" x 3" conc. mon. with 3" brass disk stamped T23N, R10W, S31, S6, S5, T22N, R10W 1968 RLS #13581, 4" Maple S 25° E 110.50, 10" Dock Spike, P.Pole S 60° W 108.63 60 Penny Spike, Center of 28" Maple S 76° W 59.20, 3" Maple N 18° W 111.56' 10" Dock spike
- 1990 Wetherell RLS# 24624, Certificate of Survey, Liber 69, page 209, corner found no description or witnesses given

**B. Description of corner evidence found and/or method applied in restoring or reestablishing corner:**

- C-13) Found U.S.F.S. Mon. set by Griffin in 1968. This corner is accepted as the best available evidence of the position of the original corner being the section Corner common to Sections 31 and 32, T23N, R10W and Sections 6 and 5, T22N, R10W

SURVEY &  
 MONUMENTATION

MAY 29 1997


COMMISSION

Peer Group Reviewed and Approved  
 Date: 14 Nov 96  
*Richard D. Wilcox*  
 Richard D. Wilcox, Wexford County Surveyor

**C. Description of monument for corner and accessories established to perpetuate locating the position of the corner:**

- C-13) 5" x 3" Conc. mon. with 3" Brass Disk stamped T23N-R10W S31, S6, S5, T22N-R10W, 1968, RLS#13854, in Centerline Road Southerly and 6' Southerly of Centerline Road East-West.

- S25°E - 110' - 8" Maple
- S60°W - 58.71' - 27" Maple
- S60°W - 108.52' - Power Pole
- S76°W - 59.66' - 34" Maple
- S57°E - 58.28' - 15" Maple - Dead
- N01°W - 40.05' - 20" Maple

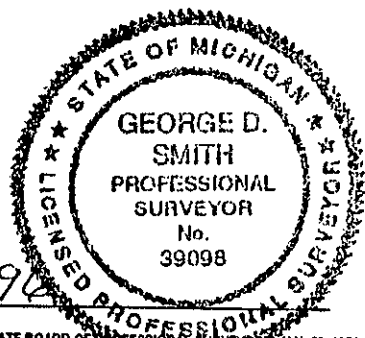

Signed by George D. Smith  
 Surveyor's Michigan License No. #39098

Date 11-29-96

FORM APPROVED BY MICHIGAN STATE BOARD OF PROFESSIONAL SURVEYORS, JAN. 28, 1971  
 REVISED MAY 14, 1975  
 REVISED JAN., 1983