

LAND CORNER RECORDATION CERTIFICATE
Filing Requirement of Act 74, Mich. P.A. 1970

For corners in Wexford
(County)

Located In:

Corner Code #

RECEIVED

1996 DEC 13 PM 3:32

Linda Loughmiller
 WEXFORD COUNTY, MI
 REGISTER OF DEEDS

1. Public Land Survey	T	<u>23N</u>	R	<u>10W</u>	<u>D-13</u>
	T		R		
	T		R		
	T		R		
2. Property Controlling in Section	S		T		
	S		T		
3. Miscellaneous Property in Section	S		T		
	S		T		

Register of Deeds Stamp & File Number

4. Lot No. _____, Recorded Plat _____
 5. Private Claims _____

I, George D. Smith, in a field survey on July 23, 1996, do hereby certify that under requirements of P.A. 74, Michigan P.A. of 1970, the corner points mentioned in lines 1 and 2 above were in conformance with regulations and rules therefore as required in the current manual of survey instructions of the United States Department of the Interior, Bureau of Land Management or by a decree of a Court of Law and/or that the corner points mentioned in lines 3, 4 and 5 above were in conformance with the rules of the Michigan Board of Professional Surveyors or by a Decree of a Court of Law; established, re-established, monumented, re-monumented, recovered, found as expressed below:

NOTE: Not more than 4 corners, all in the same town and range, may be recorded on this certificate.

A. Description of original monument and accessories and/or subsequent restoration:

- D-13) 1837 GLO Quarter Section Post by John Brink, Deputy Surveyor, Beech 8 N 25° E 41, Beech N 25° W 44
- 1968 Griffin RLS# 13584 LCRC, Liber 1, Page 438 set by extending distance between SW and W 1/16 corner East 1303.34, Set 5" x 3' concrete post with 3" brass disk stamped T23N, R10W 1/4, S32, S5, T22N, R10W 1968, RLS #13584 10" dock spk. in 5" maple N 56° E 59.41', 10" dock spk. in 5" Maple S 34° E 35.77', 10" dock spk. in TW 8" Maple N 24° W 43.02', Position checks with GLO swamp call to East
- 19?? WCRC witnesses no date given, witnesses are the same as Griffin LCRC
- 1987 Wilcox Certificate of Survey by J.L. Wilcox, RLS #14102, Liber 2, Page 355 corner found no description or witnesses given

B. Description of corner evidence found and/or method applied in restoring or reestablishing corner:

- D-13) Found U.S.F.S. Conc. Mon. ±10' Northerly of Centerline Road East-West. This corner is accepted as the best available evidence of the position of the original corner being the 1/4 corner common to Section 32, T23N, R10W and Section 5, T22N, R10W.

SURVEY &
 (REMONUMENTATION)
 MAY 20 1997
 COMMISSION


Peer Group Reviewed and Approved
 Date: 14 Nov 96
Richard D. Wilcox
 Richard D. Wilcox, Wexford County Surveyor

C. Description of monument for corner and accessories established to perpetuate locating the position of the corner:

- D-13) U.S.F.S. Conc. Mon. with 3" Brass Disk stamped T23N-R10W 1/4 S32, S5, T22N-R10W, 1968, RLS#13584
 N56°E - 59.37' - 7" Maple
 S34°E - 35.87' - 8" Maple
 N24°W - 42.97' - 10" Tw. Maple
 S46°W - 46.73' - 5" Hemlock

Signed by George D. Smith
 Surveyor's Michigan License No. #39098

Date 11-21-96

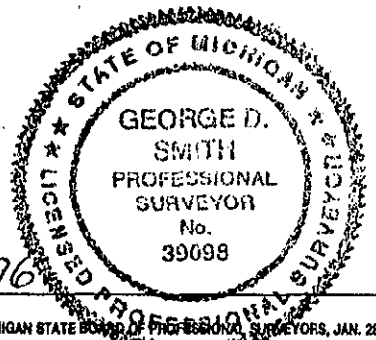

FORM APPROVED BY MICHIGAN STATE BOARD OF PROFESSIONAL SURVEYORS, JAN. 28, 1971
 REVISED MAY 14, 1975
 REVISED JAN, 1983