

MAY 20 1997

LAND CORNER RECORDATION CERTIFICATE
Filing Requirement of Act 74, Mich. P.A. 1970

COMMISSION

RECEIVED

1996 DEC 13 PM 3:33

Linda Loughmiller
WEXFORD COUNTY, MI
REGISTER OF DEEDS

Register of Deeds Stamp & File Number

For corners in
Wexford
(County)

Located In:

Corner Code #

- 1. Public Land Survey T 23N R 10W G-13
2. Property Controlling in Section S T R
3. Miscellaneous Property in Section S T R

- 4. Lot No. Recorded Plat
5. Private Claims

Grid table with columns A-L and rows 2-13 containing numbers 1-36.

I, George D. Smith, in a field survey on August 15, 1996, do hereby certify that under requirements of P.A. 74, Michigan P.A. of 1970, the corner points mentioned in lines 1 and 2 above were in conformance with regulations and rules therefore as required in the current manual of survey instructions of the United States Department of the Interior, Bureau of Land Management or by a decree of a Court of Law and/or that the corner points mentioned in lines 3, 4 and 5 above were in conformance with the rules of the Michigan Board of Professional Surveyors or by a Decree of a Court of Law; established, re-established, monumented, re-monumented, recovered, found as expressed below:

NOTE: Not more than 4 corners, all in the same town and range, may be recorded on this certificate.

A. Description of original monument and accessories and/or subsequent restoration:

- G-13) 1837 GLO Quarter Section Post by John Brink, Deputy Surveyor, Sugar 14 N 54 1/2° E 33, Beech 14 N 54° W 34
1908 D.E. Teed Survey, Liber 1, Page 295 found iron stake Sugar 12 S 68° W, Sugar S 4 3/4° W 35.8' Elm S 40° W 52 1/2'
1984 Mitchell RLS#28417, LCRC, Liber 03, Page 345, found R.R. spike at recorded bearing and dist. from standing Teed witness tree added Wexford County Monument, S 68° W 38', Maple 26' (Teed wit.) N 22° E 1/2" re-rod 13.63', S 65° E 12" Maple 28.64', N 48° E 14" Maple 47.85'.
1987 Wilcox, RLS #14102, Certificate of Survey, Liber 2, Page 362 found Wexford County Monument (witnesses on the survey are incorrect)
1992 Ray RLS #25869 Certificate of Survey, Liber 72, Page 134, found Wexford County Monument (witness on the survey are incorrect).

B. Description of corner evidence found and/or method applied in restoring or reestablishing corner:

- G-13) Found Wexford Co. Mon. with Aluminum cap as set by 1984 Mitchell survey, this position is accepted as the best available evidence of the position of the original corner being the Section corner common to Sections 33 and 34, T23N, R10W and Sections 4 and 3, T22N, R10W.

MAY 20 1997

COMMISSION

Peer Group Reviewed and Approved


Date: 14 Nov 96

Richard D. Wilcox, Wexford County Surveyor

C. Description of monument for corner and accessories established to perpetuate locating the position of the corner:

- G-13) Wexford County Mon. with Aluminum Cap

- N48°E - 47.81' - 16" Maple
N65°E - 36.68' - 20" Maple
S78°W - 26.38' - 40" Maple
N22°E - 13.61' - 1/2 re-rod in Centerline Road
S50°W - 48.68' - 24" Maple

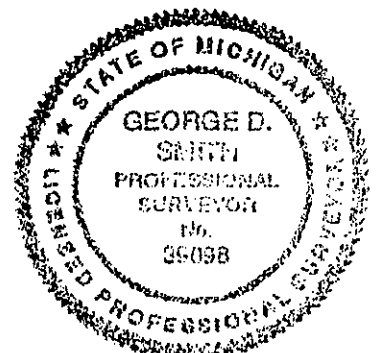

Signed by George D. Smith
Surveyor's Michigan License No. #39098

Date 11-21-96