

**SURVEY &
REMONUMENTATION**

APR 25 1995

COMMISSION

**LAND CORNER RECORDATION CERTIFICATE
Filing Requirement of Act 74, Mich. P.A. 1970**

1994 DEC -9 PM 4: 24

Linda Doughmiller
WEXFORD COUNTY, MI
REGISTER OF DEEDS

For corners in

Wexford

(County)

Located In:

Corner Code #

- | | | |
|---------------------------------------|---------------------------|------------|
| 1. Public Land Survey | T <u>23N</u> R <u>10W</u> | <u>M-2</u> |
| | T _____ R _____ | _____ |
| | T _____ R _____ | _____ |
| | T _____ R _____ | _____ |
| 2. Property Controlling
in Section | S _____ T _____ R _____ | _____ |
| | S _____ T _____ R _____ | _____ |
| 3. Miscellaneous
Property in Sec. | S _____ T _____ R _____ | _____ |
| | S _____ T _____ R _____ | _____ |

Register of Deeds Stamp & File Number

4. Lot No. _____, Recorded Plat _____
5. Private Claims _____

I, George D. Smith, in a field survey on November 3, 19 94, do hereby certify that under requirements of P.A. 74, Michigan P.A. of 1970, the corner points mentioned in lines 1 and 2 above were in conformance with regulations and rules therefore as required in the current manual of survey instructions of the United States Department of the Interior, Bureau of Land Management or by a decree of a Court of Law and/or that the corner points mentioned in lines 3, 4 and 5 above were in conformance with the rules of the Michigan Board of Land Surveyors or by a Decree of a Court of Law; established, re-established, monumented, re-monumented, recovered, found as expressed below:

NOTE: Not more than 4 corners, all in the same town and range, may be recorded on this certificate.

	A	B	C	D	E	F	G	H	I	J	K	L	M
2	6	5	4	3	2	1							
3													
4	7	8	9	10	11	12							
5													
6	18	17	16	15	14	13							
7													
8	19	20	21	22	23	24							
9													
10	30	29	28	27	26	25							
11													
12	31	32	33	34	35	36							
13													

A. Description of original monument and accessories and/or subsequent restoration:

- M-2) 1838 GLO Section post by John Brink, Deputy Surveyor, 8" Beech S 42 1/2° W 39, 12" Sugar N 24° W 18
- M-2) 1989 Wilcox LCRC Liber 04, Page 17: Set 1/2" Iron at proportionate distance to GLO; S 86° W 36.15' Power Pole, N 79° W 57.27' 8" Jack Pine, N 46° W 67.71' 10" Jack Pine, S 78° W 43.03' fence corner
- M-2) 1989 Wilcox Certificate of Survey, Liber 69, Page 341-342
- M-2) 1993 Wilcox Certificate of Survey, Liber 72, Page 254: Found 1/2" Iron

B. Description of corner evidence found and/or method applied in restoring or reestablishing corner:

Found 1/2" Iron and cap ±5' East of centerline of road North-South and 5' North of old fence line to East. This corner is accepted as a careful and faithful reestablishment of the position of the original corner, being the 1/4 corner common to Section 1, T23N, R10W and Section 6, T23N, R9W.

C. Description of monument for corner and accessories established to perpetuate locating the position of the corner:


Set 5/8" x 36" Iron with Wexford county brass cap stamped E 1/4 Section 1, 1994, PS 33989

- N 89° W - 36.11' - Power pole
- S 87° E - 33.00' - 1/2" Iron and cap
- S 87° E - 32.60' - Corner fence post
- N 51° E - 46.18' - Fence post
- N 44° W - 67.72' - 9" Jack Pine

Peer Group Reviewed and Approved

Date: 12-2-94
Richard D. Wilcox
Richard D. Wilcox, Wexford County Surveyor

LIBER **004** PAGE **324**

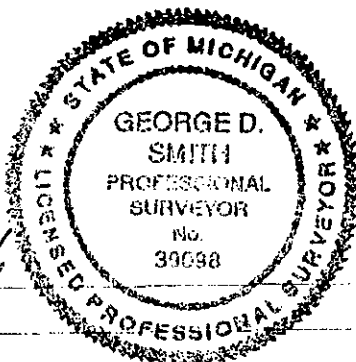

Signed by George D. Smith
Surveyor's Michigan License No. 39098

Date 11/29/94