

**SURVEY &
REMONUMENTATION**

APR 25 1995

COMMISSION

LAND CORNER RECORDATION CERTIFICATE
Filing Requirement of Act 74, Mich. P.A. 1970

RECEIVED
1994 DEC -9 PM 4: 24

For corners in

Wexford

(County)

Located In:

Corner Code #

- | | | |
|------------------------------------|---------------------------|------------|
| 1. Public Land Survey | T <u>23N</u> R <u>10W</u> | <u>M-3</u> |
| | T _____ R _____ | _____ |
| | T _____ R _____ | _____ |
| | T _____ R _____ | _____ |
| 2. Property Controlling in Section | S _____ T _____ R _____ | _____ |
| | S _____ T _____ R _____ | _____ |
| 3. Miscellaneous Property in Sec. | S _____ T _____ R _____ | _____ |
| | S _____ T _____ R _____ | _____ |

Linda Longmiller
WEXFORD COUNTY, MI
REGISTER OF DEEDS

Register of Deeds Stamp & File Number

4. Lot No. _____, Recorded Plat _____
5. Private Claims _____

	A	B	C	D	E	F	G	H	I	J	K	L	M
2	6		5		4		3		2		1		
3													
4	7		8		9		10		11		12		
5													
6	18		17		16		15		14		13		
7													
8	19		20		21		22		23		24		
9													
10	30		29		28		27		26		25		
11													
12	31		32		33		34		35		36		

I, George D. Smith, in a field survey on August 11, 19 94, do hereby certify that under requirements of P.A. 74, Michigan P.A. of 1970, the corner points mentioned in lines 1 and 2 above were in conformance with regulations and rules therefore as required in the current manual of survey instructions of the United States Department of the Interior, Bureau of Land Management or by a decree of a Court of Law and/or that the corner points mentioned in lines 3, 4 and 5 above were in conformance with the rules of the Michigan Board of Land Surveyors or by a Decree of a Court of Law; established, re-established, monumented, re-monumented, recovered, found as expressed below:

NOTE: Not more than 4 corners, all in the same town and range, may be recorded on this certificate.

A. Description of original monument and accessories and/or subsequent restoration:

- M-3) 1838 GLO post by John Brink, Deputy Surveyor, 10" Beech N 23 1/2° W 13, 12" Hemlock S 75° W 05
- M-3) 1853 GLO subdivision of Section 6 & 7, T23N, R9W by V.W. Calkins, Deputy Surveyor, 8" Hemlock N 50° E 33, 18" Hemlock S 43° E 17
- M-3) 1968 MSHD Gov't monument witness record, Form 280, Liber 2, page 832, Set 5/16" copper weld rod, Hub South 50', Hub South 75', 30" Maple S 28° W 62.68
- M-3) 1977 Nelson Certificate of Survey in Section 7, T23N, R9W, Set re-rod 1978 Nelson LCRC, Liber 03, page 162, Set 5/8" Iron and cap
- M-3) 1989 J.L. Wilcox LCRC, Liber 4, page 16, Found Iron, 8" W. Pine S 62° E 125.47', 30" Maple S 29° W 62.68', cable riser S 68° W 75.15', cable riser N 59° W 70.80'
- M-3) 1993 J.L. Wilcox Certificate of Survey, Liber 72, Page 254: Found 1/2" Iron in monument box

B. Description of corner evidence found and/or method applied in restoring or reestablishing corner:

Found 5/8" x 18" Iron ±1' South of centerline of East-West road and 2.5' East of centerline of road North. This corner is accepted as a careful and faithful reestablishment of the position of the original corner, being the Section corner common to Sections 1 and 12, T23N, R10W and Sections 6 and 7, T23N, R9W.

Peer Group Reviewed and Approved

Date: 12-9-94
Richard D. Wilcox
Richard D. Wilcox, Wexford County Surveyor


C. Description of monument for corner and accessories established to perpetuate locating the position of the corner:

Set 5/8" x 36" Iron with Wexford County brass cap stamped NE 12, 1994, PS 33989

- S 62° E - 125.39' - 10" White Pine (found MSHD tag)
- S 29° W - 63.67' - 30" Maple
- N 18° W - 93.83' - Twin 6" Elm
- S 65° W - 99.38' - 13" White Pine

LIBER **004** PAGE **317**

Signed by *George D. Smith*
Surveyor's Michigan License No. 39098

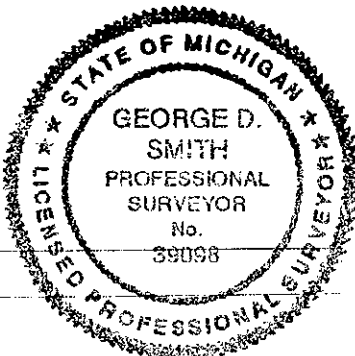

Date 12/9/94