

APR 28 1998

SECTION

LAND CORNER RECORDATION CERTIFICATE
Filing Requirement of Act 74, Mich. P.A. 1970

RECEIVED
1998 DEC 30 PM 2: 12

Linda Langhammer
WEXFORD COUNTY, MI
REGISTER OF DEEDS

For corners in

Wexford Located In: Corner Code #
(County)
1. Public Land Survey T 23N R 10W M-10
Common to
2. Property Controlling S
in Section S
3. Miscellaneous S
Property in Sec. S A-10 T23N, R9W

Register of Deeds Stamp & File Number

4. Lot No. _____, Recorded Plat _____
5. Private Claims _____

	A	B	C	D	E	F	G	H	I	J	K	L	M
1													
2		6		5		4		3		2			1
3													
4		7		8		9		10		11			12
5													
6		18		17		16		15		14			13
7													
8		19		20		21		22		23			24
9													
10		30		29		28		27		26			25
11													
12		31		32		33		34		35			36
13													

I, George D. Smith, P.S., in a field survey on April 29, 19 98 do hereby state that under requirements of P.A. 74, Michigan P.A. of 1970, the corner points mentioned in lines 1 and 2 above were in conformance with regulations and rules therefore as required in the current manual of survey instructions of the United States Department of the Interior, Bureau of Land Management or by a decree of a Court of Law and for that the corner points mentioned in lines 3, 4 and 5 above were in conformance with the rules of the Michigan Board of Land Surveyors or by a Decree of a Court of Law; established, re-established, monumented, recovered, found as expressed below:

NOTE: Not more than 2 corners, all in the same town and range, may be recorded on this certificate.

A. Description of original monument and accessories and/or subsequent restoration:

- M-10) 1838 GLO Section Post by John Brink, Deputy Surveyor; Beech 6-S34 1/2 W-12; Lynn 6-N71 1/2 W-14
- M-10) 1898 D. Teed Survey, Liber 1, Page 275. Found beech witnesses, SW ok no new witnesses given.
- M-10) 1914 D. Teed Survey Liber 1, Page 274. Corner found Elm 20-N34E-9.4'; Sugar 12-N26E-30.3
- M-10) 1981 J. Milletics PS# 25859 Cert. of Survey, Liber 1, Page 866. Found mon. S60E-7.20-18" Cottonwood; N55E-30.85'-24" Cottonwood; S75W-50.45'-12" Cottonwood
- M-10) 1985 Mitchell PS# 28417 Cert. of Survey Liber 2, Pages 133-138. Found Wexford Co. Mon. N45E-30.8', 12" Cherry, S80E-7.55'-10" Cherry; S85W-50.50'-10" Cherry
- M-10) 1988 Barnett PS 16923 Cert. of Survey Liber 67, Page 527. Found monument, no witnesses given.

B. Description of corner evidence found and/or method applied in restoring or reestablishing corner:

Found Wexford Co. Mon. ± 6' westerly of north-south fence and 2 witnesses from 1985 Mitchell PS# 28417 Cert. of Survey. This corner is accepted as the best available evidence of the position on the original corner being the quarter corner common to Section 25, T23N-R10W and Section 30, T23N, R9W.


C. Description of monument for corner and accessories established to perpetuate locating the position of the corner:

Wexford Co. Mon. stamped PS 39098, 1998, E 1/4 25.
N55E 31.58' 14" Cherry
S50E 7.58' 14" Cherry (Mitchell 7.55')
S70W 50.82' 12" Cherry (Mitchell 50.50')
N40W 8.47' 4" Cottonwood

Peer Group Reviewed and Approved

Date 9 December 1998
Richard D. Wilcox
Richard D. Wilcox, Wexford County Surveyor

Signed by *George D. Smith*
Surveyor's Michigan License No. 39098

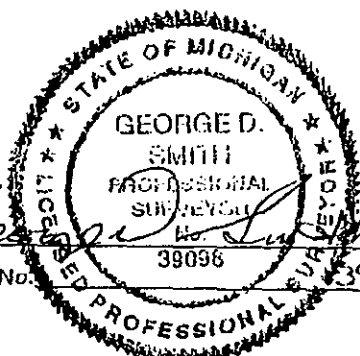

Date 12-9-98