


LAND CORNER RECORDATION CERTIFICATE
Filing Requirement of Act 74, Mich. PA 1970

For Corners In: Wexford (County)	Located In	Corner Code #
1. Public Land Survey	T <u>23N</u> R <u>10W</u>	<u>F5</u>
2. Property Controlling in Section	S _____ T _____ R _____	_____
3. Miscellaneous Property in Section	S _____ T _____ R _____	_____
4. Lot No: _____	Recorded Plat: _____	
5. Private Claims: _____		

Register of Deeds Stamp & File Number

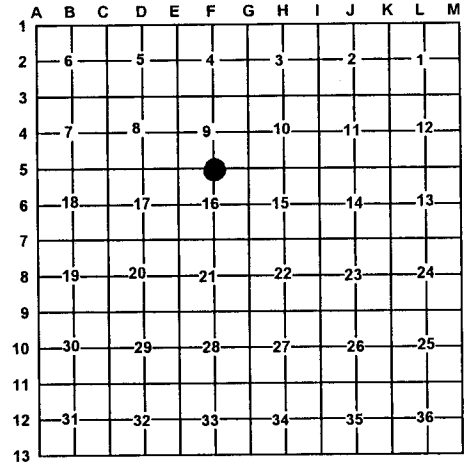

I, Craig W. McVean, in a field survey on June 5, 2007 do hereby state that under requirements of PA 74, Michigan PA of 1970, the corner points mentioned in lines 1 and 2 above were in conformance with regulations and rules therefore as required in the current manual of survey instructions of the United States Department of the Interior, Bureau of Land Management or by a decree of a Court of Law and/or that the corner points mentioned in lines 3, 4 and 5 above were in conformance with the rules of the Michigan Board of Land Surveyors or by a Decree of a Court of Law; established, re-established, monumented, recovered, found as expressed below:

NOTE: Not more than 2 corners, all in the same town and range, may be recorded on this certificate.

A. Description of original monument and accessories and/or subsequent restoration:

F5 – 1852 – GLO Resurvey – Set Ironwood post – L. S. Scranton
 1) Sugar 20" N38°W 14 L.
 2) Beech 14" S32°E 36 L.
 Old corner 2.28 Chs. South and 43 lks. West. One coarse reversed
 - 1885 – CSR – FB.63, p. 1, 2 & 16 - A. J. Teed – Found Old Stake and one witness.
 Set good Hem. Stake. Distance East 40 + 24; West 40 + 6

B. Description of corner evidence found and/or method applied in restoring or re-establishing corner:

F5 – ¼ Corner common to Sections 9 & 16, T23N, R10W - No evidence of GLO witnesses. Could find no evidence of A. J. Teeds Hemlock post. From 'E5' measured grid distance N89°56'19"E 1311.16' (1321.98' - AJT) to Fd. 1" iron bar in Mon. Box in No. 29 ¼ Rd. at W 1/16 Corner common to Section 9 & 16 that is accepted as A. J. Teed's position per 1885 Survey. Thence continued N89°56'19"E 1311.16' (1321.98' – AJT) to a "doubled over position that falls on the NW side of a 21" S. Maple w/ ancient E-W fence remains through it. Ancient E-W fence being 1' to 2' South. Thence S89°58'24"E 2635.37' (2640' – GLO, 2655.84' – AJT) to 'G5'. "Doubled over position" is N17°29' W 2.12' of straight line single proportion to A. J. Teed distances. Felt fitting historical monuments and occupation to the West was best solution for corner 'F5'. Thus accepted "doubled over position" as a careful and faithful reestablishment of the position of the original corner and set stamped 1 ½" Wexford Co. Brass Cap on 5/8" x 34" rebar with 3" x 7" long PVC filled with concrete around cap.

C. Description of monument for corner and accessories established to perpetuate locating the position of the corner:

F5 – Stamped 1 ½" Wexford County Brass Cap on 5/8" x 34" rebar with 3" x 7" long PVC filled with concrete.

N35°W 19.21' to set nail and tag in Southwest side 15" Sugar Maple
 N21°E 22.76' to set nail and tag in Southeast side 4" Sugar Maple
 S88°E 27.90' to set nail and tag in North side 15" Sugar Maple
 S56°W 10.32' to set nail and tag in North side 4" Sugar Maple
 Set Orange Carsonite Post 1' North



Signed by: Craig W. McVean
 Surveyor's Michigan License No.: 39088

Date: 12/11/2007