

LAND CORNER RECORDATION CERTIFICATE
Filing Requirement of Act 74, Mich. PA 1970

For Corners In: _____ Located In _____ Corner Code # _____
Wexford _____
(County)

- | | | | | | |
|--------------------------------------|---|------------|---|------------|------------|
| 1. Public Land Survey | T | <u>23N</u> | R | <u>10W</u> | <u>G-5</u> |
| | T | _____ | R | _____ | _____ |
| 2. Property Controlling in Section | S | _____ | T | _____ | R |
| | S | _____ | T | _____ | R |
| 3. Miscellaneous Property in Section | S | _____ | T | _____ | R |
| | S | _____ | T | _____ | R |


4. Lot No: _____ Recorded Plat: _____

5. Private Claims: _____

I, Craig W. McVean, in a field survey on May 24, 2007 do hereby state that under requirements of PA 74, Michigan PA of 1970, the corner points mentioned in lines 1 and 2 above were in conformance with regulations and rules therefore as required in the current manual of survey instructions of the United States Department of the Interior, Bureau of Land Management or by a decree of a Court of Law and/or that the corner points mentioned in lines 3, 4 and 5 above were in conformance with the rules of the Michigan Board of Land Surveyors or by a Decree of a Court of Law; established, re-established, monumented, recovered, found as expressed below:

NOTE: Not more than 2 corners, all in the same town and range, may be recorded on this certificate.

Register of Deeds Stamp & File Number

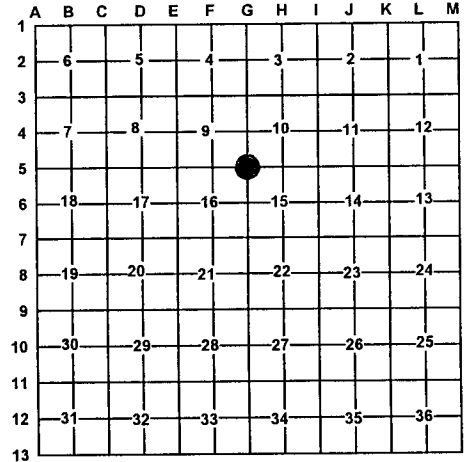

A. Description of original monument and accessories and/or subsequent restoration:

- G-5 – 1852 – GLO Resurvey – Set Elm post – L. S. Scranton
 1) Sugar 20" S15°E 58 L.
 2) Sugar 10" N64°W 10 L.
 Old corner 60 L. West and 2.50 Chs. South
 - 1885 – CSR – A. J. Teed – 40.24 Chs. to 'F5'

B. Description of corner evidence found and/or method applied in restoring or re-establishing corner:

- G-5 – Section corner common to Sections 9, 10, 15 and 16, T23N R10W - Found 1" x 2" x 2.2' long narrow gauge railroad track iron in line with E-W fences. Fence corner for fences running N & E is 25' east. Down King post with down fence running North and West is 35.5' west of found iron. Down fence remains to South is 19'± West. Found narrow gauge railroad track iron accepted as the best available evidence of the position of the original corner.

C. Description of monument for corner and accessories established to perpetuate locating the position of the corner:

- G-5 – Replaced found narrow gauge railroad track iron with stamped 4" aluminum DNR cap on 1" x 36" galvanized pipe. Placed cobble stones at bottom of monument and around cap.

- N44°E 11.90' to set nail and tag in northwest side 8" Sugar Maple scribed 'XBT'
 S87°E 43.20' to set nail and tag in south side 6" Red Pine scribed 'XBT'
 S44°E 11.61' to set nail and tag in southwest side 8" Sugar Maple scribed 'XBT'
 N65°W 25.50' to set nail and tag in north side 6" Red Pine
 Set Blue Carsonite Post 1' southeast



Signed by: Craig W. McVean
 Surveyor's Michigan License No.: 39088

Date: 12/11/2007