


LAND CORNER RECORDATION CERTIFICATE

Filing Requirement of Act 74, Mich. PA 1970

| | | |
|---|-------------------------|---------------|
| For Corners In: Wexford (County) | Located In | Corner Code # |
| 1. Public Land Survey | T 23N R 9W | A8 |
| | T 23N R 10W | M8 |
| 2. Property Controlling in Section | S _____ T _____ R _____ | _____ |
| | S _____ T _____ R _____ | _____ |
| 3. Miscellaneous Property in Section | S _____ T _____ R _____ | _____ |
| | S _____ T _____ R _____ | _____ |
| 4. Lot No: _____ | Recorded Plat: _____ | |
| 5. Private Claims: _____ | | |

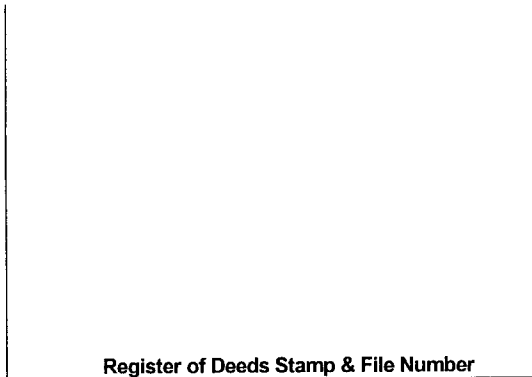

I, Craig W. McVean, in a field survey on April 12, 2007 do hereby state that under requirements of PA 74, Michigan PA of 1970, the corner points mentioned in lines 1 and 2 above were in conformance with regulations and rules therefore as required in the current manual of survey instructions of the United States Department of the Interior, Bureau of Land Management or by a decree of a Court of Law and/or that the corner points mentioned in lines 3, 4 and 5 above were in conformance with the rules of the Michigan Board of Land Surveyors or by a Decree of a Court of Law; established, re-established, monumented, recovered, found as expressed below:

NOTE: Not more than 2 corners, all in the same town and range, may be recorded on this certificate.

| | | | | | | | | | | | | |
|----|----|---|----|---|----|---|----|---|----|---|----|---|
| A | B | C | D | E | F | G | H | I | J | K | L | M |
| 1 | | | | | | | | | | | | |
| 2 | 6 | | 5 | | 4 | | 3 | | 2 | | 1 | |
| 3 | | | | | | | | | | | | |
| 4 | 7 | | 8 | | 9 | | 10 | | 11 | | 12 | |
| 5 | | | | | | | | | | | | |
| 6 | 18 | | 17 | | 16 | | 15 | | 14 | | 13 | |
| 7 | | | | | | | | | | | | |
| 8 | 19 | | 20 | | 21 | | 22 | | 23 | | 24 | |
| 9 | | | | | | | | | | | | |
| 10 | 30 | | 29 | | 28 | | 27 | | 26 | | 25 | |
| 11 | | | | | | | | | | | | |
| 12 | 31 | | 32 | | 33 | | 34 | | 35 | | 36 | |
| 13 | | | | | | | | | | | | |

A. Description of original monument and accessories and/or subsequent restoration:

- A8/M8 – 1838 - GLO Quarter Section Post by John Brink, Deputy Surveyor
 - 1) Maple 6", S77½°W 40; 2) Maple 10" – S69½°W 41
 - 1977 – J. L. Wilcox, PS # 14102, Certificate of Survey L. 1, P. 540. Set Wexford Co. Monument.
 - 3) West 12" Poplar 12.0; 4) S60°W 8" Cherry 31.28;
 - 5) N55°W, 8" poplar 35.83
 - 1977 – J. L. Wilcox, PS # 14102, Certificate of Survey L. 1, p. 610. Set Wexford Co. Mon.
 - 1977 – J. L. Wilcox, PS #14102, LCRC L. 3, p. 141. Set Wexford Co. Mon. Witness same as 1977 Cert. of Survey
- 1993 – D. Geers. PS# 33977, Cert. of Survey, L. 72, p. 485. Found Wexford Co. Mon. witnesses same as 1977 Wilcox PS #14102 LCRC.
- 1998 – LCRC – L. 5, p. 137 – G. D. Smith. Found Wexford Co. Mon. and 2 witnesses from 1977 Wilcox PS #14102 LCRC. Wexford Co. Mon. stamped PS #39098, 1998, E1/4 24.
 - 3) S60°W 11.95' – 12" poplar (Wilcox 12.00')
 - 4) N55° 38.89' 8" Cherry (Wilcox 31.28')
 - 6) S70°W 88.64' 8" Red Pine
 - 7) South 47.99' 5" Cherry

B. Description of corner evidence found and/or method applied in restoring or re-establishing corner:

A8/M8 – Standard ¼ corner common to Sec. 19, T23N, R9W and Sec. 24, T23N, R10W – Fd. 4" Wexford Co. Aluminum Monument per Remon. LCRC L. 5, p. 137 at SW'ly edge of small swamp. Add stamping "1/4 S24|S19" to cap. No GLO evidence. Witnesses as follows: 1, 2, & 5 – Gone; 3 & 7 – Stumps; 4 – Maple not Cherry; 6 – OK. Wexford Co. Mon. accepted as a careful and faithful reestablishment of the position of the original corner.

C. Description of monument for corner and accessories established to perpetuate locating the position of the corner:

A8/M8 – 4" Wexford Co. Aluminum Monument
 Fd. Orange Carsonite post 0.8' North
 Set Cedar guard post 1' SSE

N58°W 38.89' to set nail and tag at fd. nail in NE side 14" Red Maple (#4)
 S69°W 88.61' to fd. nail and tag in North side 11" Red Pine (#6)
 S27°W 15.28' to set nail and tag in NW side 4" Red Pine scribed 'XBT'
 S37°E 30.30' to set nail and tag in NE side 6" Elm



Signed by: Craig W. McVean
 Surveyor's Michigan License No.: 39088

Date: 2/6/2008