

LAND CORNER RECORDATION CERTIFICATE
Filing Requirement of Act 74, Mich. PA 1970



For Corners In: _____ Located In _____ Corner Code # _____
Wexford (County)

1. Public Land Survey T _____ R _____
T _____ R _____
2. Property Controlling in Section S 14 T 23N R 10W 5
S 14 T 23N R 10W 11
3. Miscellaneous Property in Section S _____ T _____ R _____
S _____ T _____ R _____

4. Lot No: _____ Recorded Plat: _____
5. Private Claims: _____

I, Craig W. McVean, in a field survey on June 6, 2007 do hereby state that under requirements of PA 74, Michigan PA of 1970, the corner points mentioned in lines 1 and 2 above were in conformance with regulations and rules therefore as required in the current manual of survey instructions of the United States Department of the Interior, Bureau of Land Management or by a decree of a Court of Law and/or that the corner points mentioned in lines 3, 4 and 5 above were in conformance with the rules of the Michigan Board of Land Surveyors or by a Decree of a Court of Law; established, re-established, monumented, recovered, found as expressed below:

NOTE: Not more than 2 corners, all in the same town and range, may be recorded on this certificate.

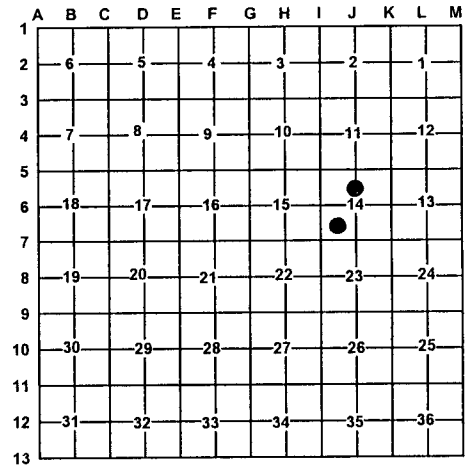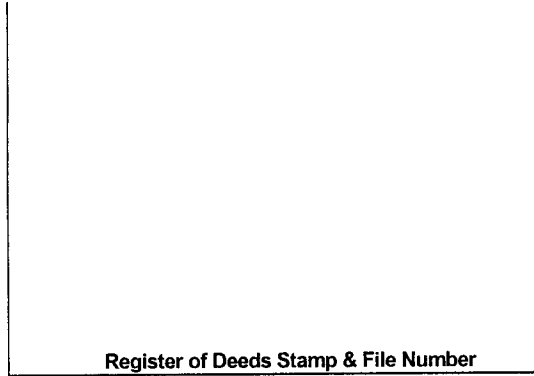

A. Description of original monument and accessories and/or subsequent restoration:
5 - None 11 - None



B. Description of corner evidence found and/or method applied in restoring or re-establishing corner:
5 - CN 1/16, Section 14, T23N, R10W
Set 2" Aluminum cap, stamped, on 5/8" x 34" rebar per standard BLM procedure. East 4'± to remains N-S fence on ground.
11 - SW 1/16, Section 14, T23N, R10W
Set 2" Aluminum cap, stamped, on 5/8" x 34" rebar per standard BLM procedure. West 14.5'± to remains N-S fence.

C. Description of monument for corner and accessories established to perpetuate locating the position of the corner:
5 - 2" Aluminum cap, stamped, on 5/8" x 34" rebar
N08°E 39.06' to set nail and tag in NW side 16" Sugar Maple
S81°E 24.77' to set nail and tag in N side 7" Ironwood
S20°E 3.34' to set nail and tag in W side 15" Sugar Maple Clp. of 4
N87°W 31.82' to set nail and tag in N. side 9" Sugar Maple
Set Blue Carsonite Post with location tag 1' South
11 - 2" Aluminum cap, stamped, on 5/8" x 34" rebar
S17°W 30.96' to set nail and tag in W. side 22" Sugar Maple
S70°W 4.52' to set nail and tag in N. side 15" Cherry
N71°E 19.95' to set nail and tag in N. side 5" Sugar Maple
S20°W 43.2' to found 1.5" steel fence post, up 3.8'
N16°W 14.69' to set N & T in E. side 12" R. Pine
Set Blue Carsonite Post with location tag 1' SW

Signed by: Craig W. McVean
Surveyor's Michigan License No.: 39088

Date: 2/6/2008