# LAND CORNER RECORDATION CERTIFICATE

Filing Requirement of Act 74, Mich. PA 1970

For Corners In:
Wexford
(County)

| | | Located In | | Corner Code # |
|---|---|---|---|---|
| 1. Public Land Survey | | T ____ | R ____ | ____ |
| | | T ____ | R ____ | ____ |
| 2. Property Controlling in Section | S 14 | T 23N | R 10W | 10 |
| | S 14 | T 23N | R 10W | 15 |
| 3. Miscellaneous Property in Section | S ____ | T ____ | R ____ | ____ |
| | S ____ | T ____ | R ____ | ____ |

Register of Deeds Stamp & File Number

4. Lot No: _____ Recorded Plat: _____

5. Private Claims: _____

I, Craig W. McVean, in a field survey on May 30, 2007 do hereby state that under requirements of PA 74, Michigan PA of 1970, the corner points mentioned in lines 1 and 2 above were in conformance with regulations and rules therefore as required in the current manual of survey instructions of the United States Department of the Interior, Bureau of Land Management or by a decree of a Court of Law and/or that the corner points mentioned in lines 3, 4 and 5 above were in conformance with the rules of the Michigan Board of Land Surveyors or by a Decree of a Court of Law; established, re-established, monumented, recovered, found as expressed below:

**NOTE: Not more than 2 corners, all in the same town and range, may be recorded on this certificate.**

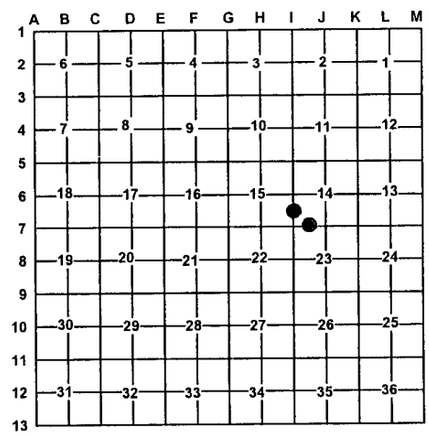


A. Description of original monument and accessories and/or subsequent restoration:

10 - None

15 - None

STATE OF MICHIGAN
CRAIG W. McVEAN
PROFESSIONAL SURVEYOR
No. 39088
LICENSED PROFESSIONAL SURVEYOR

B. Description of corner evidence found and/or method applied in restoring or re-establishing corner:

10 – S 1/16 corner common to Sections 14 & 15, T23N, R10W - Set 2" stamped Aluminum cap on 5/8" x 34" rebar per standard BLM procedure. Centerline N-S 2-track is 8' East.

15 – W 1/16 common to Sections 14 & 23, T23N, R10W – Set stamped 2" Aluminum cap on 5/8" x 34" rebar per standard BLM procedure. Corner in E-W Brush line.

C. Description of monument for corner and accessories established to perpetuate locating the position of the corner:

10 – 2" stamped Aluminum cap on 5/8" x 34" rebar
N68°E 75.58' to set nail and tag in SE side 17" W. Pine
S34°E 90.14' to set nail and tag in SW side 4" W. Pine
S47°W 60.12' to set nail and tag in NW side 10" twin S. Maple
N17°W 24.13' to set nail and tag in W side 13" S. Maple
Set Cedar Post with location tag 1' SW

15 – 2" stamped Aluminum cap on 5/8" x 34" rebar
S27°W 42.04' to set nail and tag on NW side 4" Cherry
S30°E 18.81' to set nail and tag in SW side 11" S. Maple
N41°E 56.31' to set nail and tag in SE side triple 11" S. Maple
N9°W 24.15' to set nail and tag in W side 12" S. Maple
Set Blue Carsonite Post 1' NW

Signed by: Craig W. McVean Date: 2/6/2008

Surveyor's Michigan License No.: 39088

FORM APPROVED BY MICHIGAN STATE BOARD OF PROFESSIONAL SURVEYORS JAN. 28, 1971
Revised May 14, 1975
Revised Jan. 1983
Revised Oct. 1995