

# LAND CORNER RECORDATION CERTIFICATE

Filing Requirement of Act 74, Mich. PA 1970

For Corners In: Wexford Located In \_\_\_\_\_ Corner Code # \_\_\_\_\_  
 (County)

- |                                      |             |              |              |          |
|--------------------------------------|-------------|--------------|--------------|----------|
| 1. Public Land Survey                | T _____     | R _____      |              |          |
|                                      | T _____     | R _____      |              |          |
| 2. Property Controlling in Section   | S <u>16</u> | T <u>23N</u> | R <u>10W</u> | <u>5</u> |
|                                      | S <u>16</u> | T <u>23N</u> | R <u>10W</u> | <u>7</u> |
| 3. Miscellaneous Property in Section | S _____     | T _____      | R _____      |          |
|                                      | S _____     | T _____      | R _____      |          |


4. Lot No: \_\_\_\_\_ Recorded Plat: \_\_\_\_\_

5. Private Claims: \_\_\_\_\_

I, Craig W. McVean, in a field survey on April 30, 2007 do hereby state that under requirements of PA 74, Michigan PA of 1970, the corner points mentioned in lines 1 and 2 above were in conformance with regulations and rules therefore as required in the current manual of survey instructions of the United States Department of the Interior, Bureau of Land Management or by a decree of a Court of Law and/or that the corner points mentioned in lines 3, 4 and 5 above were in conformance with the rules of the Michigan Board of Land Surveyors or by a Decree of a Court of Law; established, re-established, monumented, recovered, found as expressed below:

**NOTE: Not more than 2 corners, all in the same town and range, may be recorded on this certificate.**

Register of Deeds Stamp & File Number

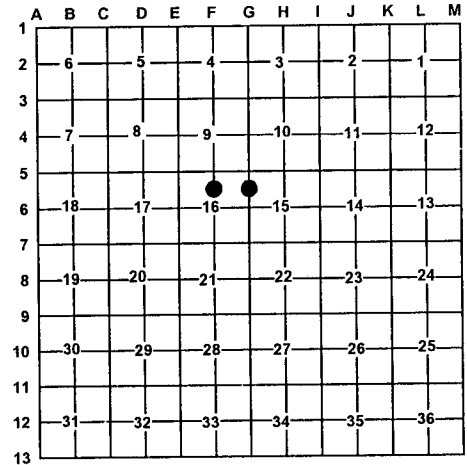

A. Description of original monument and accessories and/or subsequent restoration:

5 - None

7 - None



B. Description of corner evidence found and/or method applied in restoring or re-establishing corner:

5 - CN 1/16 Section 16, T23N, R10W. Set stamped 2" Aluminum cap on 5/8" x 34" rebar per standard BLM procedure.

7 - N 1/16 common to Sections 15 & 16, T23N, R10W. Set stamped 2" Aluminum cap on 5/8" x 34" rebar per standard BLM procedure. East 41'± to fence remains N-S.

C. Description of monument for corner and accessories established to perpetuate locating the position of the corner:

5 - Stamped 2" Aluminum cap on 5/8" x 34" rebar  
 N57°E 9.83' to set nail and tag in NW side 14" S. Maple  
 S8°E 13.46' to set nail and tag in W side 12" S. Maple  
 N5°E 20.08' to set nail and tag in E side 23" S. Maple  
 N78°W 48.00' to set nail and tag in N side 9" R. Pine  
 Set Blue Carsonite Post with location tag 1' Southeast

7 - Stamped 2" Aluminum cap on 5/8" x 34" rebar  
 N6°E 23.22' to set nail and tag in W side 7" S. Maple  
 N86°E 49.18' to set nail and tag in E side 9" S. Maple  
 S1°E 46.95' to set nail and tag in N side 10" S. Maple  
 S73°W 22.19' to set nail and tag in N side 4" Beech  
 Set Blue Carsonite Post with location tag 1' Southeast

Signed by: Craig W. McVean  
 Surveyor's Michigan License No.: 39088

Date: 2/6/2008