


LAND CORNER RECORDATION CERTIFICATE
Filing Requirement of Act 74, Mich. PA 1970

For Corners In: Wexford (County)	Located In	Corner Code #
1. Public Land Survey	T _____ R _____	_____
	T _____ R _____	_____
2. Property Controlling in Section	S 16 T 23N R 10W	12
	S 16 T 23N R 10W	13
3. Miscellaneous Property in Section	S _____ T _____ R _____	_____
	S _____ T _____ R _____	_____
4. Lot No: _____	Recorded Plat: _____	
5. Private Claims: _____		

Register of Deeds Stamp & File Number

I, Craig W. McVean, in a field survey on June 7, 2007 do hereby state that under requirements of PA 74, Michigan PA of 1970, the corner points mentioned in lines 1 and 2 above were in conformance with regulations and rules therefore as required in the current manual of survey instructions of the United States Department of the Interior, Bureau of Land Management or by a decree of a Court of Law and/or that the corner points mentioned in lines 3, 4 and 5 above were in conformance with the rules of the Michigan Board of Land Surveyors or by a Decree of a Court of Law; established, re-established, monumented, recovered, found as expressed below:

NOTE: Not more than 2 corners, all in the same town and range, may be recorded on this certificate.

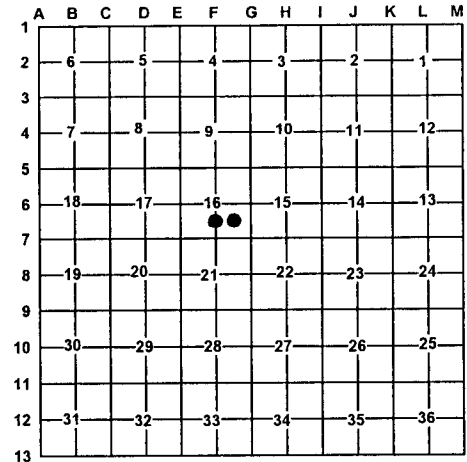

A. Description of original monument and accessories and/or subsequent restoration:

12 - None 13 - None



B. Description of corner evidence found and/or method applied in restoring or re-establishing corner:

12 - CS 1/16, Section 16, T23N, R10W.
Set stamped 2" Aluminum Cap on 5/8" x 34" rebar per Standard BLM procedure. East 49' to N-S Fence

13 - SE 1/16, Section 16, T23N, R10W.
Set stamped 2" Aluminum Cap on 5/8" x 34" rebar Per Standard BLM procedure.

C. Description of monument for corner and accessories established to perpetuate locating the position of the corner:

12 - Stamped 2" Aluminum cap on 5/8" x 34" rebar
S57°W 13.55' to set nail and tag in N. side 16" Sugar Maple
S46°E 21.86' to set nail and tag in SW side 3" Sugar Maple
N67°E 50.62' to set nail and tag in N. side 28" Beech
N25°E 85.55' to set nail and tag in SE side 3" Beech
Set Cedar Post with location tag 1' NE

13 - Stamped 2" Aluminum cap on 5/8" x 34" rebar
S45°W 7.34' to set nail and tag in NW side
9" Beech scribed 'XBT'
N63°E 17.48' to set nail and tag in N. side 7" Sugar Maple
N68°W 10.70' to set nail and tag in S. side 11" Sugar Maple
S44°E 29.05' to set nail and tag in NE side 10" Sugar Maple
Set Blue Carsonite Post with location tag 1' NE

Signed by: Craig W. McVean
Surveyor's Michigan License No.: 39088

Date: 2/6/2008