

SURVEY & REMONUMENTATION

FEB 11 1998

SECTION

LAND CORNER RECORDATION CERTIFICATE
 Filing Requirement of Act 74, Mich. P.A. 1970

For corners in

WEXFORD Located In: Corner Code #
 (County)

1. Public Land Survey T 23N R 12W B-13
 T _____ R _____
 T _____ R _____
 T _____ R _____

2. Property Controlling S _____ T _____ R _____
 in Section S _____ T _____ R _____

3. Miscellaneous S _____ T _____ R _____
 Property in Sec. S _____ T _____ R _____

4. Lot No. _____, Recorded Plat _____

5. Private Claims _____

RECEIVED
 1997 DEC 11 AM 9:27
Linda Loughmiller
 WEXFORD COUNTY, MI
 REGISTER OF DEEDS

Register of Deeds Stamp & File Number

1	A	B	C	D	E	F	G	H	I	J	K	L
2		6		5		4		3		2		1
3												
4		7		8		9		10		11		12
5												
6		18		17		16		15		14		13
7												
8		19		20		21		22		23		24
9												
10		30		29		28		27		26		25
11												
12		31		32		33		34		35		36
13												

I, CRAIG J. PULLEN, in a field survey on MAY 19, 1997, do hereby state that under requirements of P.A. 74, Michigan P.A. of 1970, the corner points mentioned in lines 1 and 2 above were in conformance with regulations and rules therefore as required in the current manual of survey instructions of the United States Department of the Interior, Bureau of Land Management or by a decree of a Court of Law and/or that the corner points mentioned in lines 3, 4 and 5 above were in conformance with the rules of the Michigan Board of Land Surveyors or by a Decree of a Court of Law; established, re-established, monumented, recovered, found as expressed below:

NOTE: Not more than 2 corners, all in the same town and range, may be recorded on this certificate.

A. Description of original monument and accessories and/or subsequent restoration:

- B-13 1838 G.L.O. SURVEY BY J. BRINK WOOD POST Y. PINE 10 N32E 26, W. PINE 10 N27W 5
- 1970 PLAT OF FOREST ACRES L.1 OF PLATS, P. 220 BY B. BATZER PS#13026 CORNER SHOWN ON PLAT NO CORNER INFORMATION GIVEN
- 1972 U.S.F.S. NOTES BY R. GRIFFIN, PS #13584, FOUND 3/8" PIPE, POST NORTH 41.75', CONCRETE MONUMENT N00°09'10"W 43.00'
- 1977 J.L. WILCOX PS#14102, L.C.R.C. L.3, P.156 FOUND 1/2" PIPE, SET WEXFORD COUNTY MONUMENT, NORTH U.S.F.S. LOCATION POST 41.75', N35°W 10" OAK 56.78', S35°W 14" OAK 53.17', N55°E 8" OAK 57.02'


B. Description of corner evidence found and/or method applied in restoring or reestablishing corner:

- B-13 FOUND WEXFORD COUNTY MONUMENT IN GOOD CONDITION 14' NORTH OF EAST-WEST TRAIL ROAD AND IN CENTERLINE OF DRIVE TO HOUSE #1148. 4 PREVIOUS WITNESSES WERE ALSO FOUND. THIS CORNER IS ACCEPTED AS THE BEST AVAILABLE EVIDENCE OF THE POSITION OF THE CORNER.

C. Description of monument for corner and accessories established to perpetuate locating the position of the corner:

- B-13 1/4 CORNER COMMON TO SECTION 31, T23N, R12W, & SECTION 6, T22N, R12W WEXFORD COUNTY MONUMENT STAMPED: CJP, 1997, 39095, 1/4, 31, 6
- N55°E 10" OAK 57.34'
- NORTH U.S.F.S. WITNESS POST 41.77'
- N27°W 14" OAK 56.81'
- S40°W 18" OAK 53.71'

Peer Group Reviewed and Approved
 Date: 30 Oct 97
Richard D. Wilcox
 Richard D. Wilcox, Wexford County Surveyor

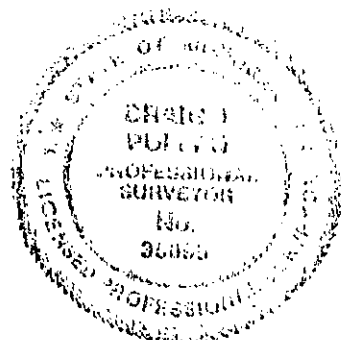

Signed by Craig J. Pullen
 Surveyor's Michigan License No. 39095

Date 2 DEC 97