

**SURVEY &
REMONUMENTATION**

FEB 11 1998

RECEIVED

1997 DEC 11 AM 9:27

LAND CORNER RECORDATION CERTIFICATE
Filing Requirement of Act 74, Mich. P.A. 1970

Linda Loughmiller
WEXFORD COUNTY, MI
REGISTER OF DEEDS

For corners in **SECTION**

WEXFORD Located In: Corner Code #
(County)

1. Public Land Survey T 23N R 12W C-13
T _____ R _____
T _____ R _____
T _____ R _____

2. Property Controlling S _____ T _____ R _____
in Section S _____ T _____ R _____

3. Miscellaneous S _____ T _____ R _____
Property in Sec. S _____ T _____ R _____

4. Lot No. _____, Recorded Plat _____

5. Private Claims _____

Register of Deeds Stamp & File Number

	A	B	C	D	E	F	G	H	I	J	K	L
1												
2	6				4							
3												
4	7			8		9		10		11		12
5												
6	18			17		16		15		14		13
7												
8	19			20		21		22		23		24
9												
10	30			29		28		27		26		25
11												
12	31			32		33		34		35		36
13												

I, CRAIG J. PULLEN, in a field survey on MAY 19, 1997, do hereby state that under requirements of P.A. 74, Michigan P.A. of 1970, the corner points mentioned in lines 1 and 2 above were in conformance with regulations and rules therefore as required in the current manual of survey instructions of the United States Department of the Interior, Bureau of Land Management or by a decree of a Court of Law and/or that the corner points mentioned in lines 3, 4 and 5 above were in conformance with the rules of the Michigan Board of Land Surveyors or by a Decree of a Court of Law; established, re-established, monumented, recovered, found as expressed below:

NOTE: Not more than 2 corners, all in the same town and range, may be recorded on this certificate.

A. Description of original monument and accessories and/or subsequent restoration:

- C-13 1838 G.L.O. SURVEY BY J. BRINK, WOOD POST Y. PINE 10 N61 1/2E 27, Y. PINE 10 N20W 25
- 1909 FARGO ENGINEERING SURVEY IN SECTION 32, T23N, R12W, FOUND OLD STAKE AND STUMPS OF BOTH U.S. WITNESSES Y. P. STUMP 24 N37E 0.76CH, W. P. STUMP 28 N71W 0.69CH
- 1969 B. BATZER PS #13026 SURVEY IN SECTION 31, T23N, R12W, 1/2" X 24" BLACK IRON PIPE SET FROM 1 FARGO WITNESS AND 4' NORTH OF CENTERLINE OF TRAIL, 14" RED PINE S3 1/2° E 45.14, 12" OAK N69° 40' W 42.54', 6" W. PINE N32° 45' E 47.20', FARGO WIT. STUMP (PINE) N71° W 45.5'
- 1977 J.L. WILCOX, PS #14102, L.C.R.C. L. 3, P. 154, FOUND 1" PIPE, SET WEXFORD COUNTY MONUMENT, S5 W 18" RED PINE 45.14', N35° E 8" WHITE PINE 47.20', N70° W 14" OAK 42.54', S60° E 9" OAK 46.28

B. Description of corner evidence found and/or method applied in restoring or reestablishing corner:


- C-13 FOUND WEXFORD COUNTY MONUMENT IN GOOD CONDITION 3' NORTH OF CENTERLINE OF 26 ROAD AND 3 PREVIOUS WITNESSES. THIS CORNER IS ACCEPTED AS A CAREFUL AND FAITHFUL PERPETUATION OF THE POSITION OF THE ORIGINAL CORNER.

C. Description of monument for corner and accessories established to perpetuate locating the position of the corner:

- C-13 SECTION CORNER COMMON TO SECTIONS 31 & 32, T23N, R12W, AND SECTIONS 5 & 6, T22N, R12W WEXFORD COUNTY MONUMENT STAMPED: CJP, 39095, 1997, 31, 32, 5, 6
- S52° E 18" WHITE OAK 57.75'
- N63° W 18" WHITE OAK 42.46'
- N33° E 9" WHITE PINE 47.15'
- S3 1/2° E 22" RED PINE 45.20'

Peer Group Reviewed and Approved

Date: 30 Oct 97
Richard D. Wilcox
Richard D. Wilcox, Wexford County Surveyor

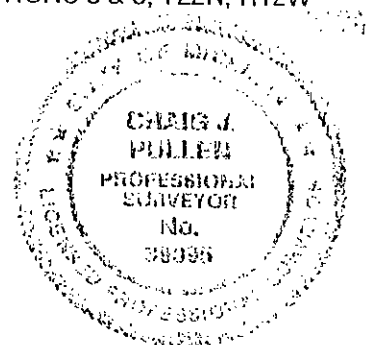

Signed by Craig J. Pullen
Surveyor's Michigan License No. 39095

Date 2 DEC 97