

SURVEY & REMONUMENTATION

FEB 1 1 1998

LAND CORNER RECORDATION CERTIFICATE
Filing Requirement of Act 74, Mich. P.A. 1970

For corners in **SECTION**

<u>WEXFORD</u> (County)	Located In:	Corner Code #
1. Public Land Survey	T <u>23N</u> R <u>12W</u>	<u>D-13</u>
	T _____ R _____	_____
	T _____ R _____	_____
	T _____ R _____	_____
2. Property Controlling in Section	S _____ T _____ R _____	_____
	S _____ T _____ R _____	_____
3. Miscellaneous Property in Sec.	S _____ T _____ R _____	_____
	S _____ T _____ R _____	_____
4. Lot No. _____, Recorded Plat _____		
5. Private Claims _____		

RECEIVED
1997 DEC 11 AM 9:29
WEXFORD COUNTY MI
REGISTER OF DEEDS

RECEIVED
1997 DEC 11 AM 9:28
WEXFORD COUNTY MI
REGISTER OF DEEDS

I, CRAIG J. PULLEN, in a field survey on MAY 19, 1997, do hereby state that under requirements of P.A. 74, Michigan P.A. of 1970, the corner points mentioned in lines 1 and 2 above were in conformance with regulations and rules therefore as required in the current manual of survey instructions of the United States Department of the Interior, Bureau of Land Management or by a decree of a Court of Law and/or that the corner points mentioned in lines 3, 4 and 5 above were in conformance with the rules of the Michigan Board of Land Surveyors or by a Decree of a Court of Law; established, re-established, monumented, recovered, found as expressed below:

NOTE: Not more than 2 corners, all in the same town and range, may be recorded on this certificate.

3					
4	7	8	9	10	11
5					
6	18	17	16	15	14
7					
8	19	20	21	22	23
9					
10	30	29	28	27	26
11					
12	31	32	33	34	35
13					

A. Description of original monument and accessories and/or subsequent restoration:

- D-13 1838 G.L.O. SURVEY BY J. BRINK WOOD POST Y. PINE 12 N86E 25, Y. PINE 12 N46W 31
- 1973 J.L. WILCOX PS#14102, L.C.R.C. L.2, P.636 FOUND 1 1/2" PIPE REPLACED WITH WEXFORD COUNTY MONUMENT IN CENTERLINE EAST-WEST ROAD, S45°W 12" OAK 33.01', S30°E 6" J. PINE 33.22', N15°E 12" TRI-OAK 52.52'
- 1977 J.L. WILCOX PS#14102, L.C.R.C. L.3, P.155 FOUND WEXFORD COUNTY MONUMENT, S40°E 10" RED-PINE, S50°W 18" OAK 32.99', N25°W 14" OAK 53.63', N10°E 48" OAK (CLUMP) 52.54'

B. Description of corner evidence found and/or method applied in restoring or reestablishing corner:


D-13 FOUND WEXFORD COUNTY MONUMENT IN POOR CONDITION IN CENTERLINE OF 26 ROAD AND 1 PREVIOUS WITNESS. REPLACED WEXFORD COUNTY MONUMENT WITH 5/8" X 36" IRON & BRASS CAP. THIS CORNER IS ACCEPTED AS THE BEST AVAILABLE EVIDENCE OF THE POSITION OF THE CORNER.

C. Description of monument for corner and accessories established to perpetuate locating the position of the corner:

- D-13 1/4 CORNER COMMON TO SECTION 32, T23N, R12W, & SECTION 5, T22N, R12W
- 5/8" X 36" IRON & BRASS CAP STAMPED: CJP, 1997, 39095, 1/4, 32, 5
- N24°W 20" OAK 53.63'
- N50°E 24" DOUBLE MAPLE 45.68'
- N68°E 10" RED PINE 96.63'
- S28°E 20" WHITE OAK 70.23'

Peer Group Reviewed and Approved

Date: 30 Oct 97
Richard D. Wilcox
Richard D. Wilcox, Wexford County Surveyor

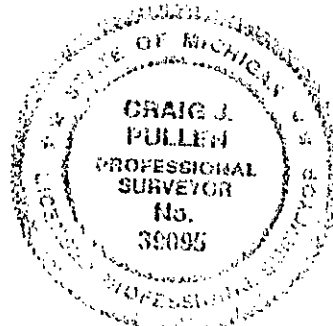

Signed by Craig J. Pullen
Surveyor's Michigan License No. 39095

Date 2 DEC 97