

SURVEY & REMONUMENTATION

FEB 11 1998

LAND CORNER RECORDATION CERTIFICATE
Filing Requirement of Act 74, Mich. P.A. 1970

RECEIVED

1997 DEC 11 AM 9:28

Linda Longmiller
WEXFORD COUNTY, MI
REGISTER OF DEEDS

SECTION
For corners in

WEXFORD Located In: Corner Code #
(County)

1. Public Land Survey T 23N R 12W H-13
T _____ R _____
T _____ R _____
T _____ R _____

2. Property Controlling S _____ T _____ R _____
in Section S _____ T _____ R _____

3. Miscellaneous S _____ T _____ R _____
Property in Sec. S _____ T _____ R _____

4. Lot No. _____, Recorded Plat _____

5. Private Claims _____

Register of Deeds Stamp & File Number

	A	B	C	D	E	F	G	H	I	J	K	L
1												
2	6			5		4		3		2		1
3												
4	7			8		9		10		11		1
5												
6	18			17		16		15		14		13
7												
8	19			20		21		22		23		24
9												
10	30			29		28		27		26		25
11												
12	31			32		33		34		35		36
13												

I, CRAIG J. PULLEN, in a field survey on MAY 20, 1997, do hereby state that under requirements of P.A. 74, Michigan P.A. of 1970, the corner points mentioned in lines 1 and 2 above were in conformance with regulations and rules therefore as required in the current manual of survey instructions of the United States Department of the Interior, Bureau of Land Management or by a decree of a Court of Law and/or that the corner points mentioned in lines 3, 4 and 5 above were in conformance with the rules of the Michigan Board of Land Surveyors or by a Decree of a Court of Law; established, re-established, monumented, recovered, found as expressed below:

NOTE: Not more than 2 corners, all in the same town and range, may be recorded on this certificate.

A. Description of original monument and accessories and/or subsequent restoration:

H-13 1838 G.L.O. SURVEY BY J. BRINK, WOOD POST, HEMLOCK 10 N76E 13, SUGAR 7 N41½ W 11
1975 J. L. WILCOX, PS #14102 L.C.R.C. L. 2, P. 813, & SURVEY L.1, P. 430, FOUND 3/4" PIPE ADDED WEXFORD COUNTY MONUMENT, S5°W 5" RED PINE 56.00', S66°E POWER POLE 91.75'
1980 GRANGER ENG. SURVEY BY J. RAY, PS #25869, FOUND WEXFORD COUNTY MONUMENT, WITNESSES SAME AS 1975 WILCOX RECORD.

B. Description of corner evidence found and/or method applied in restoring or reestablishing corner:


H-13 FOUND WEXFORD COUNTY MONUMENT IN POOR CONDITION 2' SOUTH OF THE CENTERLINE OF 26 ROAD AND 10' EAST OF DRIVE TO SOUTH AND 1 PREVIOUS WITNESS. REPLACED WEXFORD COUNTY MONUMENT WITH 5/8" X 36" IRON & BRASS CAP. THIS CORNER IS ACCEPTED AS THE BEST AVAILABLE EVIDENCE OF THE POSITION OF THE CORNER.

C. Description of monument for corner and accessories established to perpetuate locating the position of the corner:

H-13 1/4 CORNER COMMON TO SECTION 34, T23N, R12W, AND SECTION 3, T22N, R12W
5/8" X 36" IRON WITH BRASS CAP STAMPED: CJP, 39095, 1997, 34, 3, 1/4
S66°E POWER POLE 91.77'
S19°E 14" RED PINE 61.19'
S56°W 10" RED PINE 84.93'
N5°W FENCE POST 25.60'

Peer Group Reviewed and Approved

Date: 30 Oct 97
Richard D. Wilcox
Richard D. Wilcox, Wexford County Surveyor

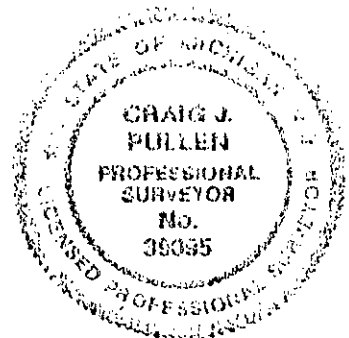

Signed by Craig J. Pullen
Surveyor's Michigan License No. 39095

Date 2 DEC 97