

SURVEY & REMONUMENTATION

FEB 11 1998

SECTION

LAND CORNER RECORDATION CERTIFICATE
Filing Requirement of Act 74, Mich. P.A. 1970

For corners in

<u>WEXFORD</u> <small>(County)</small>	Located In:	Corner Code #	
1. Public Land Survey	T <u>23N</u> R <u>12W</u>	<u>I-13</u>	
	T _____ R _____	_____	
	T _____ R _____	_____	
	T _____ R _____	_____	
2. Property Controlling in Section	S _____ T _____ R _____	_____	
	S _____ T _____ R _____	_____	
3. Miscellaneous Property in Sec.	S _____ T _____ R _____	_____	
	S _____ T _____ R _____	_____	
4. Lot No. _____, Recorded Plat _____			
5. Private Claims _____			

RECEIVED

1997 DEC 11 AM 9:28

Linda Loughmiller
WEXFORD COUNTY, MI
REGISTER OF DEEDS

Register of Deeds Stamp & File Number

	A	B	C	D	E	F	G	H	I	J	K	L
1												
2	6		5		4		3		2		1	
3												
4	7		8		9		10		11		12	
5												
6	18		17		16		15		14		13	
7												
8	19		20		21		22		23		24	
9												
10	30		29		28		27		26		25	
11												
12	31		32		33		34		35		36	
13												

I, CRAIG J. PULLEN, in a field survey on MAY 20, 1997, do hereby state that under requirements of P.A. 74, Michigan P.A. of 1970, the corner points mentioned in lines 1 and 2 above were in conformance with regulations and rules therefore as required in the current manual of survey instructions of the United States Department of the Interior, Bureau of Land Management or by a decree of a Court of Law and/or that the corner points mentioned in lines 3, 4 and 5 above were in conformance with the rules of the Michigan Board of Land Surveyors or by a Decree of a Court of Law; established, re-established, monumented, recovered, found as expressed below:

NOTE: Not more than 2 corners, all in the same town and range, may be recorded on this certificate.

A. Description of original monument and accessories and/or subsequent restoration:


- I-13 1838 G.L.O. SURVEY BY J. BRINK, WOOD POST, BEECH 10 N78½ E 33, SUGAR 12 N76W 46
 1975 J. L. WILCOX, PS #14102 L.C.R.C. L. 2, P. 813, & SURVEY L.1, P. 430, FOUND 1½" WELL POINT, ADDED WEXFORD COUNTY MONUMENT IN CENTERLINE OF 2-TRACK, N05°E 12" MAPLE 49.05', S60°W 18" MAPLE 50.27', S25°E 12" MAPLE 56.45'
 1986 MITCHELL & ASSOC. SURVEY L. 2, P. 192, & L.C.R.C. L. 3, P. 386 BY R. MITCHELL PS #28417, FOUND WEXFORD COUNTY MONUMENT ON CENTERLINE OF E-W TRAIL ROAD, N05°E 14" MAPLE 48.73', S20°E 14" MAPLE 56.21', S60°W 16" W. ASH 50.28', N52°W 10" MAPLE 46.50'

B. Description of corner evidence found and/or method applied in restoring or reestablishing corner:

- I-13 FOUND WEXFORD COUNTY MONUMENT IN EXCELLENT CONDITION IN CENTERLINE OF 2-TRACK AND 4 PREVIOUS WITNESSES. THIS CORNER IS ACCEPTED AS THE BEST AVAILABLE EVIDENCE OF THE POSITION OF THE CORNER.

C. Description of monument for corner and accessories established to perpetuate locating the position of the corner:

- I-13 SECTION CORNER COMMON TO SECTIONS 34 & 35, T23N, R12W, AND SECTIONS 2 & 3, T22N, R12W WEXFORD COUNTY MONUMENT STAMPED: CJP, 39095, 1997, 34, 35, 2, 3
 N12°E 19" MAPLE 48.74'
 S8°E 20" MAPLE 56.34'
 S70°W 24" ASH 50.33'
 N52°W 12" TRIPLE MAPLE 46.57'

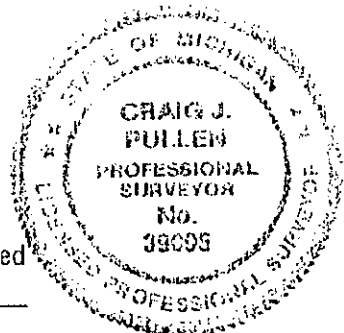

Peer Group Reviewed and Approved

Date: 30 Oct 97
Richard D. Wilcox
 Richard D. Wilcox, Wexford County Surveyor

Signed by Craig J. Pullen
 Surveyor's Michigan License No. 39095

Date 2 DEC 97