

# SURVEY & REMONUMENTATION

FEB 11 1998

## LAND CORNER RECORDATION CERTIFICATE Filing Requirement of Act 74, Mich. P.A. 1970

For corners in **SECTION**

<u>WEXFORD</u> <small>(County)</small>	Located In:	Corner Code #	
1. Public Land Survey	<u>T 23N</u> <u>R 12W</u>	<u>J-13</u>	
	T _____ R _____	_____	
	T _____ R _____	_____	
	T _____ R _____	_____	
2. Property Controlling in Section	S _____ T _____ R _____	_____	
	S _____ T _____ R _____	_____	
3. Miscellaneous Property in Sec.	S _____ T _____ R _____	_____	
	S _____ T _____ R _____	_____	
4. Lot No. _____, Recorded Plat _____			
5. Private Claims _____			

RECEIVED  
1997 DEC 11 AM 9:28  
*Linda Loughmiller*  
WEXFORD COUNTY, MI  
REGISTER OF DEEDS

Register of Deeds Stamp & File Number

	A	B	C	D	E	F	G	H	I	J	K	L
1												
2	6			5		4		3		2		1
3												
4	7			8		9		10		11		12
5												
6	18			17		16		15		14		13
7												
8	19			20		21		22		23		24
9												
10	30			29		28		27		26		25
11												
12	31			32		33		34		35		36
13												

I, CRAIG J. PULLEN, in a field survey on JUNE 30, 1997, do hereby state that under requirements of P.A. 74, Michigan P.A. of 1970, the corner points mentioned in lines 1 and 2 above were in conformance with regulations and rules therefore as required in the current manual of survey instructions of the United States Department of the Interior, Bureau of Land Management or by a decree of a Court of Law and/or that the corner points mentioned in lines 3, 4 and 5 above were in conformance with the rules of the Michigan Board of Land Surveyors or by a Decree of a Court of Law, established, re-established, monumented, recovered, found as expressed below:

**NOTE: Not more than 2 corners, all in the same town and range, may be recorded on this certificate.**

**A. Description of original monument and accessories and/or subsequent restoration:**


J-13 1837 G.L.O. SURVEY BY J. BRINK, WOOD POST, HEMLOCK 12 N81E 46, HEMLOCK 13 N48W 45  
1986 MITCHELL & ASSOC. SURVEY L. 2, P. 192, & L.C.R.C. L. 3, P. 386, BY R. MITCHELL PS #28417, SET 36" LONG 5" SQUARE CONCRETE MONUMENT WITH BRASS CAP ON FENCE LINE TO SOUTH AND AT SPLIT OF EAST AND WEST R/W FENCES AND IN THE CENTER OF EAST AND WEST TRAIL ROAD. THIS POSITION FITS NEARLY PRORATED BETWEEN SECTION CORNERS 1/2 MILE EAST AND WEST. S52°W 12" MAPLE 32.39', N60°W 12" ASH 31.16', S50°E 10" RED PINE 43.60', N27°E 14" MAPLE 57.01'

**B. Description of corner evidence found and/or method applied in restoring or reestablishing corner:**

J-13 FOUND UNITED STATES FOREST SERVICE CONCRETE MONUMENT WITH BRASS CAP IN SOUTHERLY TRACK OF EAST-WEST 2-TRACK AND 21' WEST OF 2-TRACK TO SOUTH AND 4 PREVIOUS WITNESSES. THIS CORNER IS ACCEPTED AS A CAREFUL AND FAITHFUL RE-ESTABLISHMENT OF THE POSITION OF THE ORIGINAL CORNER.

**C. Description of monument for corner and accessories established to perpetuate locating the position of the corner:**

J-13 1/4 CORNER COMMON TO SECTION 35, T23N, R12W, AND SECTION 2, T22N, R12W  
5" X 36" CONCRETE MONUMENT WITH BRASS CAP STAMPED: RFM, 28417, 1986, 35, 2, 1/4  
N60°W 14" ASH 31.17'  
N27°E 16" MAPLE 57.03'  
S50°E 14" RED PINE 43.60'  
S52°W 16" MAPLE 32.47'

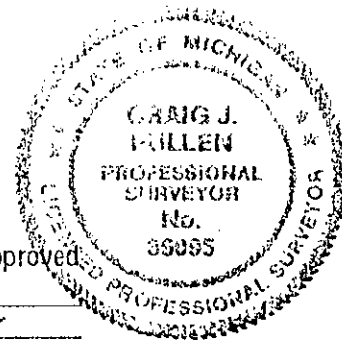

Peer Group Reviewed and Approved

Date: 30 Oct 97  
*Richard D. Wilcox*  
Richard D. Wilcox, Wexford County Surveyor

Signed by *Craig Pullen*  
Surveyor's Michigan License No. 39095

Date 2 DEC 97