

**SURVEY &  
REMONUMENTATION**

**FEB 11 1998**

**SECTION**

**LAND CORNER RECORDATION CERTIFICATE  
Filing Requirement of Act 74, Mich. P.A. 1970**

For corners in

WEXFORD Located In: Corner Code #  
(County)

1. Public Land Survey T 23N R 12W L-13  
T \_\_\_\_\_ R \_\_\_\_\_  
T \_\_\_\_\_ R \_\_\_\_\_  
T \_\_\_\_\_ R \_\_\_\_\_

2. Property Controlling S \_\_\_\_\_ T \_\_\_\_\_ R \_\_\_\_\_  
in Section S \_\_\_\_\_ T \_\_\_\_\_ R \_\_\_\_\_

3. Miscellaneous S \_\_\_\_\_ T \_\_\_\_\_ R \_\_\_\_\_  
Property in Sec. S \_\_\_\_\_ T \_\_\_\_\_ R \_\_\_\_\_

4. Lot No. \_\_\_\_\_, Recorded Plat \_\_\_\_\_

5. Private Claims \_\_\_\_\_

RECEIVED

1997 DEC 11 AM 9:28

*Linda Loughmiller*  
WEXFORD COUNTY, MI  
REGISTER OF DEEDS

Register of Deeds Stamp & File Number

	A	B	C	D	E	F	G	H	I	J	K	L
1												
2	6		5		4		3		2			
3												
4	7			8		9		10		11		12
5												
6	18			17		16		15		14		13
7												
8	19			20		21		22		23		24
9												
10	30			29		28		27		26		25
11												
12	31			32		33		34		35		36
13												

I, CRAIG J. PULLEN, in a field survey on JULY 1, 1997, do hereby state that under requirements of P.A. 74, Michigan P.A. of 1970, the corner points mentioned in lines 1 and 2 above were in conformance with regulations and rules therefore as required in the current manual of survey instructions of the United States Department of the Interior, Bureau of Land Management or by a decree of a Court of Law and/or that the corner points mentioned in lines 3, 4 and 5 above were in conformance with the rules of the Michigan Board of Land Surveyors or by a Decree of a Court of Law; established, re-established, monumented, recovered, found as expressed below:

**NOTE: Not more than 2 corners, all in the same town and range, may be recorded on this certificate.**

**A. Description of original monument and accessories and/or subsequent restoration:**

- L-13 1837 G.L.O. SURVEY BY J. BRINK, WOOD POST, BEECH 13 N68½ E 27 BEECH 7 N19W 18  
1904 A. J. TEED SURVEY IN SECTION 1, T22N, R12W, SET STAKE HALFWAY AND ON LINE BETWEEN NE AND NW CORNERS OF SECTION 1, SUGAR 12 S63½ E 15, SUGAR 14 N58½ W 48  
1909 D. E. TEED SURVEY IN SECTION 36, T23N, R12W, NO CORNER DESCRIPTION GIVEN, BEECH 16 S66W 24½  
1986 MITCHELL & ASSOC. SURVEY L. 2, P. 192, & L.C.R.C. L. 3, P. 387, BY R. MITCHELL PS #28417, FOUND 1¼" BY 36" IRON PIPE AT END OF FENCE TO THE WEST THAT AGREES WELL WITH A. J. TEED SURVEY OF RECORD. REPLACED WITH 5" BY 60" CONCRETE MONUMENT WITH BRASS CAP, S10°E 18" MAPLE 7.35', S50°E 7" MAPLE 11.10', N36°W 14" MAPLE 30.61', N10°E 10" MAPLE 16.98'

**B. Description of corner evidence found and/or method applied in restoring or reestablishing corner:**


- L-13 FOUND UNITED STATES FOREST SERVICE CONCRETE MONUMENT WITH BRASS CAP 1.5' OUT OF GROUND AND IN LINE WITH DOWN FENCE TO WEST AND 4 PREVIOUS WITNESSES. THIS CORNER IS ACCEPTED A CAREFUL AND FAITHFUL RE-ESTABLISHMENT OF THE POSITION OF THE ORIGINAL CORNER.

**C. Description of monument for corner and accessories established to perpetuate locating the position of the corner:**

- L-13 1/4 CORNER COMMON TO SECTION 36, T23N, R12W, AND SECTION 1, T22N, R12W  
5" X 36" CONCRETE MONUMENT WITH BRASS CAP STAMPED: RFM, 28417, 1986, 36, 1, 1/4  
N36°W 18" MAPLE 30.70'  
N32°E 12" MAPLE 16.98'  
S10°E 18" MAPLE 7.35'  
S72°W 14" MAPLE 27.16'

Peer Group Reviewed and Approved

Date: 30 Oct 97  
*Richard D. Wilcox*  
Richard D. Wilcox, Wexford County Surveyor

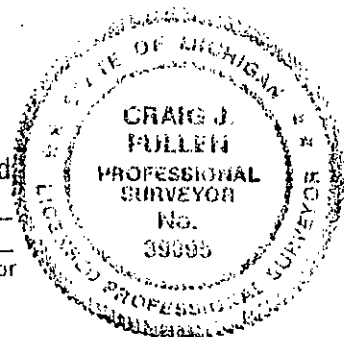

Signed by *Craig J. Pullen*  
Surveyor's Michigan License No. 39095

Date 2 DEC 97

FORM APPROVED BY MICHIGAN STATE BOARD OF PROFESSIONAL SURVEYORS, JAN. 28, 19  
REVISED MAY 14, 19  
REVISED JAN. 19  
REVISED OCT., 19