

SURVEY & REMONUMENTATION

RECEIVED

APR 25 1995

LAND CORNER RECORDATION CERTIFICATE
Filing Requirement of Act 74, Mich. P.A. 1970

1994 DEC -9 PM 2: 57

For corners of **COMMISSION**
WEXFORD

Linda Loughmiller
WEXFORD COUNTY, MI
REGISTER OF DEEDS

	Located In:		Corner Code #	
		23N 12W	M-2	
1. Public Land Survey	T	_____ R _____	_____	_____
	T	_____ R _____	_____	_____
	T	_____ R _____	_____	_____
	T	_____ R _____	_____	_____
2. Property Controlling in Section	S	_____ T _____ R _____	_____	_____
	S	_____ T _____ R _____	_____	_____
3. Miscellaneous Property in Sec.	S	_____ T _____ R _____	_____	_____
	S	_____ T _____ R _____	_____	_____
4. Lot No. _____, Recorded Plat _____				
5. Private Claims _____				

Register of Deeds Stamp & File Number

I, **CRAIG J. PULLEN**, in a field survey on **JUNE 22**, 19 **94**, do hereby certify that under requirements of P.A. 74, Michigan P.A. of 1970, the corner points mentioned in lines 1 and 2 above were in conformance with regulations and rules therefore as required in the current manual of survey instructions of the United States Department of the Interior, Bureau of Land Management or by a decree of a Court of Law and/or that the corner points mentioned in lines 3, 4 and 5 above were in conformance with the rules of the Michigan Board of Land Surveyors or by a Decree of a Court of Law; established, re-established, monumented, re-monumented, recovered, found as expressed below:

	A	B	C	D	E	F	G	H	I	J	K	L	M
2	6	5	4	3	2	1							
3													
4	7	8	9	10	11	12							
5													
6	18	17	16	15	14	13							
7													
8	19	20	21	22	23	24							
9													
10	30	29	28	27	26	25							
11													
12	31	32	33	34	35	36							
13													

NOTE: Not more than 4 corners, all in the same town and range, may be recorded on this certificate.

A. Description of original monument and accessories and/or subsequent restoration:

- M-2 1838 GLO SURVEY BY J. BRINK. WOOD POST BEECH 8 S86W 10 BEECH 6 N52W 06
- 1902 DEVOE SURVEY IN SECTION 6, T23N, R11W IRON ROD, ORIGINAL GOV. PT. TEL. POLE N2°W 30 LINKS S45°E 39½ LINKS.
- 1903 D. TEED SURVEY IRON & STONE TEL. POLE N83¼W 29½ TEL. POLE S62 3/4E 40
- 1977 J. WILCOX #14102 L.C.R.C. L.3, P.168 FOUND 1" BAR IN MON. BOX N80°W 16" MAPLE 34.35' S80°E 12" ASH 41.64' S45°E 8" ASH 61.67' N35°W 16" MAPLE 70.42'
- 1986 GRANGER ENG. SURVEY J. RAY #25869 L.2 P.294 IRON IN MON. BOX EAST CENTERLINE M-37 2.5' N76°W 18" MAPLE 34.50' S44°W SIGN POST 55.45' EAST ½" IRON 33.00'
- 1987 GRANGER ENG. SURVEY J. RAY #25869 L.65, P.151 IRON IN MON. BOX WITNESSED SAME AS 1986.
- 1988 J. L. WILCOX SURVEY L.66, P.197 1" IRON IN MON. BOX WITNESSES SAME AS 1977 WITNESSES.

B. Description of corner evidence found and/or method applied in restoring or reestablishing corner:


M-2 FOUND 5/8" IRON IN MON. BOX AND 3 WITNESSES FROM 1977 L.C.R.C. L.3, P.168. THIS CORNER IS ACCEPTED AS A CAREFUL AND FAITHFUL PERPETUATION OF THE POSITION OF THE ORIGINAL CORNER, BEING THE ¼ CORNER COMMON TO SECTION 1, T23N, R12W, AND SECTION 6, T23N, R11W. SET WEXFORD COUNTY BRASS CAP ON EXISTING 5/8" IRON.

Peer Group Reviewed and Approved

Date: 12-2-94
Richard D. Wilcox
Richard D. Wilcox, Wexford County Surveyor

C. Description of monument for corner and accessories established to perpetuate locating the position of the corner:

- M-2 E¼ CORNER, SECTION 1, T23N, R12W
- 5/8" IRON WITH BRASS CAP STAMPED: CJP 39095, SC, ¼, 1, 6, 1994
- N82°W 32" MAPLE 34.41'
- N56°W P.POLE 54.84'
- S78°E 24" ASH 41.60'
- S42°E 16" ASH 61.42'
- WEST ½" IRON 33.00'

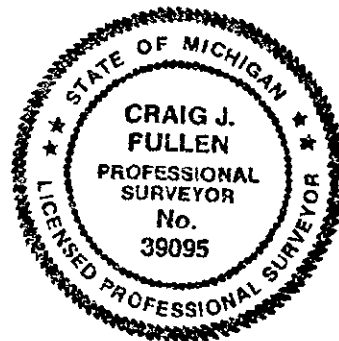

LIBER **04** PAGE **296**

Signed by *Craig J. Pullen* Date NOVEMBER 22, 1994

Surveyor's Michigan License No. 39095