

RECEIVED

1994 DEC -9 PM 2: 58

LAND CORNER RECORDATION CERTIFICATE
Filing Requirement of Act 74, Mich. P.A. 1970

For corners in WEXFORD

Linda Loughmiller
WEXFORD COUNTY, MI
REGISTER OF DEEDS

Form with fields for (County), Located In: (Town/Range), Corner Code #, and numbered sections 1-5 for survey details.

Register of Deeds Stamp & File Number

Grid table with columns A-M and rows 2-13, containing numerical values for section identification.

CRAIG J. PULLEN JUNE 22 94

I, CRAIG J. PULLEN, in a field survey on JUNE 22, 1994, do hereby certify that under requirements of P.A. 74, Michigan P.A. of 1970, the corner points mentioned in lines 1 and 2 above were in conformance with regulations and rules therefor as required in the current manual of survey instructions of the United States Department of the Interior, Bureau of Land Management or by a decree of a Court of Law and/or that the corner points mentioned in lines 3, 4 and 5 above were in conformance with the rules of the Michigan Board of Land Surveyors or by a Decree of a Court of Law; established, re-established, monumented, re-monumented, recovered, found as expressed below:

NOTE: Not more than 4 corners, all in the same town and range, may be recorded on this certificate.

A. Description of original monument and accessories and/or subsequent restoration:

- List of survey descriptions including GLO SURVEY BY J. BRINK, DEVOE SURVEY, D.E. TEED SURVEY, A.J. TEED SURVEY, J.L. WILCOX SURVEY, and GRANGER ENG. SURVEY.


B. Description of corner evidence found and/or method applied in restoring or reestablishing corner:

M-3 FOUND 1" BAR IN MON. BOX AT INTERSECTION OF M-37 & M-42 AND 2 WITNESSES FROM 1986. REMOVED BAR AND SET 5/8" X 24" IRON WITH BRASS CAP IN ITS PLACE.

Peer Group Reviewed and Approved
Date: 12-2-94
Richard D. Wilcox, Wexford County Surveyor

C. Description of monument for corner and accessories established to perpetuate locating the position of the corner:

- Survey monument details for M-3: 3/4" NE CORNER, SECTION 12, T23N, R12W; 5/8" X 24" IRON WITH BRASS CAP STAMPED; N47°E POWER POLE 59.33'; S38°E SW CORNER FACE OF FENCE 53.68'; S53°W POWER POLE 84.20'; N54°W 12" BOX ELDER 71.15'.

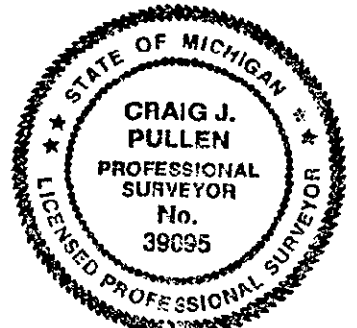

LIBER 04 PAGE 297

NOVEMBER 22, 1994

Signed by Craig J. Pullen 39095
Surveyor's Michigan License No.