

**SURVEY & REMONUMENTATION**

APR 25 1995

**LAND CORNER RECORDATION CERTIFICATE**  
Filing Requirement of Act 74, Mich. P.A. 1970

RECEIVED

1994 DEC -9 PM 2: 58

For corners in **COMMISSION**  
**WEXFORD**

*Linda Loughmiller*  
WEXFORD COUNTY, MI  
REGISTER OF DEEDS

(County)	Located In:	Corner Code #
	23N 12W	M-4
1. Public Land Survey	T _____ R _____	_____
	T _____ R _____	_____
	T _____ R _____	_____
	T _____ R _____	_____
2. Property Controlling in Section	S _____ T _____ R _____	_____
	S _____ T _____ R _____	_____
3. Miscellaneous Property in Sec.	S _____ T _____ R _____	_____
	S _____ T _____ R _____	_____
4. Lot No. _____, Recorded Plat _____		
5. Private Claims _____		

Register of Deeds Stamp & File Number

I, **CRAIG J. PULLEN**, in a field survey on **JUNE 21**, 19 **94**, do hereby certify that under requirements of P.A. 74, Michigan P.A. of 1970, the corner points mentioned in lines 1 and 2 above were in conformance with regulations and rules therefore as required in the current manual of survey instructions of the United States Department of the Interior, Bureau of Land Management or by a decree of a Court of Law and/or that the corner points mentioned in lines 3, 4 and 5 above were in conformance with the rules of the Michigan Board of Land Surveyors or by a Decree of a Court of Law, established, re-established, monumented, re-monumented, recovered, found as expressed below:

	A	B	C	D	E	F	G	H	I	J	K	L	M
2	6	5	4	3	2	1							
3													
4	7	8	9	10	11	12							
5													
6	18	17	16	15	14	13							
7													
8	19	20	21	22	23	24							
9													
10	30	29	28	27	26	25							
11													
12	31	32	33	34	35	36							

**NOTE: Not more than 4 corners, all in the same town and range, may be recorded on this certificate.**

A. Description of original monument and accessories and/or subsequent restoration:

- M-4 1838 GLO SURVEY BY J. BRINK. WOOD POST BEECH 8 S62W 08 HEM 14 N1½W 22
- 1910 A.J. TEED SURVEY GAS PIPE & STAKE & STONE NO WITNESSES GIVEN
- 1970 WEX. CO. ROAD COMM. BOOK ½ ROD 4" DEEP WILCOX 1970 6" ELM N45°E 82.92' 6" PINE N50°W 50.33' 4" PINE N75°W 29.33'
- 1976 J.L. WILCOX SURVEY PS#14102 L.1 P.470 ½" IRON ROD SAME WITNESSES AS 1970
- 1979 J.L. WILCOX SURVEY L.1 P.698 FOUND ½" IRON ROD SET WEX. CO. MON. S45°W 66.10' 6" WHITE PINE S49°30'E 54.18' 4" RED PINE
- 1980 GRANGER ENG. SURVEY J. RAY PS#25869 FOUND WEX. CO. MON. IN CENTERLINE GRAVEL ROAD. S78°E 6" R. PINE 38.68' S43°W 6" W. PINE 65.95' N76°W 6" R. PINE 29.18' N45°W 8" R. PINE 50.40'
- 1993 WILCOX SURVEY L.72 P.929 J. DEAN GEERS PS#33977 WEX. CO. MON. S38°E 53.15' 8" R. PINE S46°W 65.75' 8" W. PINE N69°W 29.20' 8" R. PINE N43°W 50.36' 8" R. PINE

B. Description of corner evidence found and/or method applied in restoring or reestablishing corner:

- M-4 FOUND WEXFORD COUNTY MONUMENT IN CENTERLINE ROAD AND 4 PREVIOUS WITNESSES. THIS CORNER IS ACCEPTED AS A CAREFUL AND FAITHFUL PERPETUATION OF THE POSITION OF THE ORIGINAL CORNER, BEING THE ¼ CORNER COMMON TO SECTION 12, T23N, R12W, AND SECTION 7, T23N, R11W.


Peer Group Reviewed and Approved

Date: 12-2-94

*Richard D. Wilcox*  
Richard D. Wilcox, Wexford County Surveyor

C. Description of monument for corner and accessories established to perpetuate locating the position of the corner:

- M-4 E¼ CORNER, SECTION 12, T23N, R12W
- WEXFORD COUNTY MONUMENT
- N73°W 10" RED PINE 29.31'
- S43°W 10" WHITE PINE 65.68'
- S41°E 10" RED PINE 53.23'
- N46°W 10" RED PINE 50.36'
- EAST 1" PIPE 33.15'

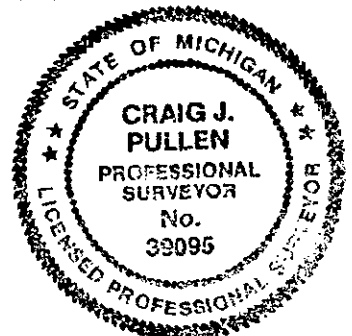

LIBER 04 PAGE 298

NOVEMBER 22, 1994

Signed by *Craig J. Pullen* Date \_\_\_\_\_  
Surveyor's Michigan License No. 39095