

SURVEY & REMONUMENTATION

FEB 11 1998

SECTION

LAND CORNER RECORDATION CERTIFICATE Filing Requirement of Act 74, Mich. P.A. 1970

For corners in

WEXFORD <small>(County)</small>	Located In:	Corner Code #	
1. Public Land Survey	T <u>23N</u> R <u>12W</u>	<u>M-9</u>	
	T _____ R _____		
	T _____ R _____		
	T _____ R _____		
2. Property Controlling in Section	S _____ T _____ R _____		
	S _____ T _____ R _____		
3. Miscellaneous Property in Sec.	S _____ T _____ R _____		
	S _____ T _____ R _____		
4. Lot No. _____, Recorded Plat _____			
5. Private Claims _____			

RECEIVED
1997 DEC 11 AM 9:29
Linda Loughmiller
WEXFORD COUNTY, MI
REGISTER OF DEEDS

Register of Deeds Stamp & File Num

I, CRAIG J. PULLEN, in a field survey on OCTOBER 28, 1997, do hereby state that under requirements of P.A. 74, Michigan P.A. of 1970, the corner points mentioned in lines 1 and 2 above were in conformance with regulations and rules therefore as required in the current manual of survey instructions of the United States Department of the Interior, Bureau of Land Management or by a decree of a Court of Law and/or that the corner points mentioned in lines 3, 4 and 5 above were in conformance with the rules of the Michigan Board of Land Surveyors or by a Decree of a Court of Law; established, re-established, monumented, recovered, found as expressed below:

NOTE: Not more than 2 corners, all in the same town and range, may be recorded on this certificate.

A. Description of original monument and accessories and/or subsequent restoration:

- M-9 1838 G.L.O. SURVEY BY J. BRINK WOOD POST SUGAR 11 S16W 05, SUGAR 8 N44W 05
- 1899 ALDERMAN SURVEY IN SECTION 24, T23N, R12W, IN TEED BOOK, NO CORNER DESCRIPTION OR WITNESSES GIVEN. DISTANCE TO NORTH IS 2629.44'
- 1915 D. E. TEED SURVEY IN SECTION 25, T23N, R12W, FOUND GOVERNMENT SUGAR WITNESS O.K. AND REMAINS OF BEECH TO NE & SE, HEM 14 N65½E 67½', SUGAR 12 S37E 81, DISTANCE TO SE CORNER OF SECTION 25, T23N, R12W, IS 5263.50'


B. Description of corner evidence found and/or method applied in restoring or reestablishing corner:

M-9 NO EVIDENCE OF THE CORNER, WITNESSES, OR OCCUPATION WAS FOUND. SET 5/8" X 36" IRON AND BRASS CAP BY SINGLE PROPORTIONATE MEASUREMENT BETWEEN THE FOUND SE CORNER OF SECTION 13 AND THE RE-ESTABLISHED SE CORNER OF SECTION 36, T23N, R12W. DISTANCES TO NORTH AND SOUTH ARE 2609.87' (2629.44'-R-NORTH). THIS CORNER IS ACCEPTED AS A CAREFUL AND FAITHFUL RE-ESTABLISHMENT OF THE POSITION OF THE ORIGINAL CORNER.

C. Description of monument for corner and accessories established to perpetuate locating the position of the corner:

- M-9 SECTION CORNER COMMON TO SECTIONS 24 & 25, T23N, R12W, & SECTIONS 19 & 30, T23N, R11W
5/8" X 36" IRON AND BRASS CAP STAMPED: CJP, 1997, 39095, 24, 25, 19, 30
- S76°E 32" RED OAK 22.16'
- N66°W 18" MAPLE 48.97'
- S22°E 4" MAPLE 29.00'
- N62°E 12" MAPLE 13.26'

Peer Group Reviewed and Approved
Date: 30 Oct 97
Richard D. Wilcox
Richard D. Wilcox, Wexford County Surveyor

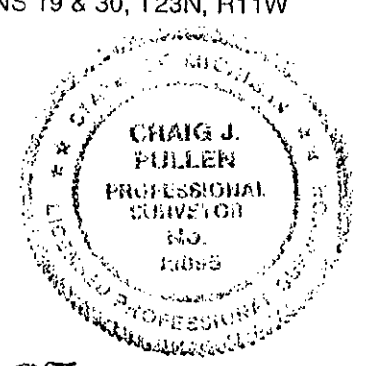

Signed by *Craig J. Pullen*
Surveyor's Michigan License No. 39095

Date 2 DEC 97