

**SURVEY &
REMONUMENTATION**

FEB 11 1998

SECTION

**LAND CORNER RECORDATION CERTIFICATE
Filing Requirement of Act 74, Mich. P.A. 1970**

For corners in

<u>WEXFORD</u> (County)	Located In:	Corner Code #
1. Public Land Survey	T <u>23N</u> R <u>12W</u>	<u>M-10</u>
	T _____ R _____	_____
	T _____ R _____	_____
	T _____ R _____	_____
2. Property Controlling in Section	S _____ T _____ R _____	_____
	S _____ T _____ R _____	_____
3. Miscellaneous Property in Sec.	S _____ T _____ R _____	_____
	S _____ T _____ R _____	_____
4. Lot No. _____, Recorded Plat _____		
5. Private Claims _____		

RECEIVED
1997 DEC 11 AM 9:29
Linda Loughmiller
WEXFORD COUNTY, MI
REGISTER OF DEEDS

Register of Deeds Stamp & File Num.

1	A	B	C	D	E	F	G	H	I	J	K	L
2		6		5		4		3		2		1
3												
4		7		8		9		10		11		12
5												
6		18		17		16		15		14		13
7												
8		19		20		21		22		23		24
9												
10		30		29		28		27		26		25
11												
12		31		32		33		34		35		36
13												

I, CRAIG J. PULLEN, in a field survey on OCTOBER 28, 1997, do hereby state that under requirements of P.A. 74, Michigan P.A. of 1970, the corner points mentioned in lines 1 and 2 above were in conformance with regulations and rules therefore as required in the current manual of survey instructions of the United States Department of the Interior, Bureau of Land Management or by a decree of a Court of Law and/or that the corner points mentioned in lines 3, 4 and 5 above were in conformance with the rules of the Michigan Board of Land Surveyors or by a Decree of a Court of Law; established, re-established, monumented, recovered, found as expressed below:

NOTE: Not more than 2 corners, all in the same town and range, may be recorded on this certificate.

A. Description of original monument and accessories and/or subsequent restoration:

- M-10 1838 G.L.O. SURVEY BY J. BRINK WOOD POST HEM 11 S55W 49, SUGAR 10 N47½ W 33
- 1915 D. E. TEED SURVEY IN SECTION 25, T23N, R12W, CORNER NOT SHOWN IN AND TOTAL DISTANCE FOR THE EAST LINE OF THE SECTION SHOWN (5263.50').


B. Description of corner evidence found and/or method applied in restoring or reestablishing corner:

M-10 NO EVIDENCE OF THE CORNER, G.L.O. WITNESSES, OR OCCUPATION WAS FOUND. SET 5/8" X 36" IRON AND BRASS CAP BY SINGLE PROPORTIONATE MEASUREMENT BETWEEN THE FOUND SE CORNER OF SECTION 13 AND THE RE-ESTABLISHED SE CORNER OF SECTION 36, T23N, R12W. DISTANCES TO NORTH AND SOUTH ARE 2609.87' (5263.60'-TEED FOR WHOLE MILE). THIS CORNER IS ACCEPTED AS A CAREFUL AND FAITHFUL RE-ESTABLISHMENT OF THE POSITION OF THE ORIGINAL CORNER.

C. Description of monument for corner and accessories established to perpetuate locating the position of the corner:

- M-10 1/4 CORNER COMMON TO SECTION 25, T23N, R12W, & SECTION 30, T23N, R11W
5/8" X 36" IRON AND BRASS CAP STAMPED: CJP, 1997, 39095, 1/4, 25, 30
NORTH 8" DOUBLE MAPLE 4.96'
N85°W 8" DOUBLE ASH 24.99'
S34°W 6" MAPLE 22.79'
S2°E 8" MAPLE 17.55'

Peer Group Reviewed and Approved
Date: 130 Oct 97
Richard D. Wilcox
Richard D. Wilcox, Wexford County Surveyor

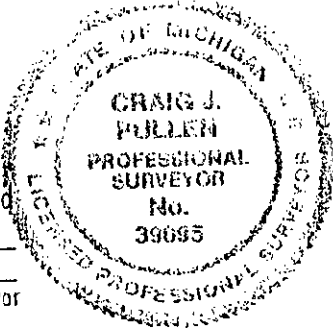

Signed by *Craig J. Pullen*
Surveyor's Michigan License No. 39095

Date 2 DEC 97