

**SURVEY & REMONUMENTATION**

**FEB 11 1998**

**SECTION**

**LAND CORNER RECORDATION CERTIFICATE**

**Filing Requirement of Act 74, Mich. P.A. 1970**

For corners in Wexford Located In: \_\_\_\_\_ Corner Code # \_\_\_\_\_  
 (County)

1. Public Land Survey	T	<u>23N</u>	R	<u>12W</u>	<u>M-11</u>
	T	_____	R	_____	_____
	T	_____	R	_____	_____
	T	_____	R	_____	_____
2. Property Controlling in Section	S	_____	T	_____	R
	S	_____	T	_____	R
3. Miscellaneous Property in Section	S	_____	T	_____	R
	S	_____	T	_____	R

4. Lot No. \_\_\_\_\_, Recorded Plat \_\_\_\_\_  
 5. Private Claims \_\_\_\_\_

**RECEIVED**  
 1997 DEC 11 AM 9:33  
*Linda Loughmiller*  
 WEXFORD COUNTY, MI  
 REGISTER OF DEEDS  
 Register of Deeds Stamp & File Number

A	B	C	D	E	F	G	H	I	J	K	L
2	6	5	4	3	2	1					
3											
4	7	8	9	10	11	12					
5											
6	18	17	16	15	14	13					
7											
8	19	20	21	22	23	24					
9											
10	30	29	28	27	26	25					
11											
12	31	32	33	34	35	36					
13											

I, George Smith, in a field survey on 10-27, 19 97, do hereby certify that under requirements of P.A. 74, Michigan P.A. of 1970, the corner points mentioned in lines 1 and 2 above were in conformance with regulations and rules therefore as required in the current manual of survey instructions of the United States Department of the Interior, Bureau of Land Management or by a decree of a Court of Law and/or that the corner points mentioned in lines 3, 4 and 5 above were in conformance with the rules of the Michigan Board of Professional Surveyors or by a Decree of a Court of Law; established, re-established, monumented, re-monumented, recovered, found as expressed below:

**NOTE: Not more than 4 corners, all in the same town and range, may be recorded on this certificate.**

**A. Description of original monument and accessories and/or subsequent restoration:**

- M-11) 1837 GLO Section Post by John Brink P.S. Hemlock S73 1/2°W 38, Hemlock 13 N47°W 45
- 1839 GLO Subdivision by John Brink, Deputy Surveyor, Beech 24 N55°E 87, Hemlock 10 S64°E 30
- 1909 D. Teed Survey, Liber 1, Page 324. Found Hemlock 10" to Southeast also found stump of Hemlock to Northwest set corner from witnesses and found hole where stake had been. Beech 12 S28°W 12 1/2, Beech 12 S21°E 45, Beech 10" N75 1/2°E 35
- 1915 Survey by D. Teed Liber 1, Page 321. Found stake set in 1909, stumps of Beech witness trees badly burned, no new witnesses

**B. Description of corner evidence found and/or method applied in restoring or reestablishing corner:**

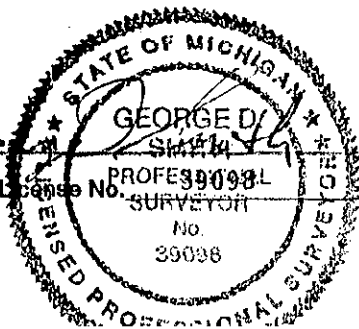
- M-11) Set 5/8"x36" iron by single proportionate measure between the re-established Southeast corner Section 36 and the found Southeast corner of Section 13, this corner is accepted as a careful and faithful re-establishment of the position of the original corner being the section corner common to Sections 25 and 36, T23N, R12W and Sections 30 and 31, T23N, R11W

**C. Description of monument for corner and accessories established to perpetuate locating the position of the corner:**

- M-11) Set 5/8"x36" iron with Wexford County Brass Cap stamped NE 36 1997, 39098 ± 75' North of old rail-road grade.

South 6.02' 6" Maple  
 S60°W 39.88' 24" Oak  
 N10°E 4.91' 16" Cherry  
 N10°W 26.14' 18" Oak

Peer Group Reviewed and Approved  
 Date: 30 Oct 97  
*Richard D. Wilcox*  
 Richard D. Wilcox, Wexford County Surveyor

Signed by George Smith  
 Surveyor's Michigan License No. 39098L  


Date 10-30-97