SURVEY &
REMONUMENTATION

FEB 1 1 1998

LAND CORNER RECORDATION CERTIFICATE

Filing Requirement of Act 74, Mich. P.A. 1970

For corners in SECTION
Wexford
(County)

RECEIVED
1997 DEC 11 AM 9:33
Linda Loughmiller
WEXFORD COUNTY, MI
REGISTER OF DEEDS

Register of Deeds Stamp & File Number

	Located In:	Corner Code #
1. Public Land Survey	T 23N R 12W	M-12
	T ___ R ___	
	T ___ R ___	
	T ___ R ___	
2. Property Controlling	S ___ T ___ R ___	
in Section	S ___ T ___ R ___	
3. Miscellaneous	S ___ T ___ R ___	
Property in Section	S ___ T ___ R ___	

4. Lot No. _____, Recorded Plat _____
5. Private Claims _____

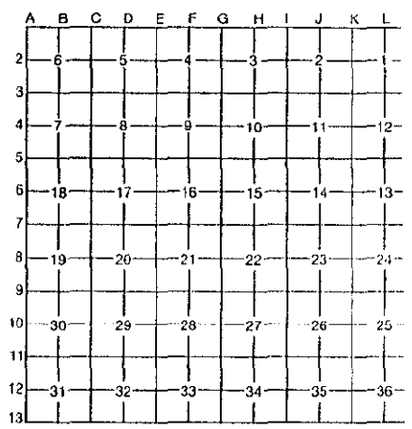

I, George Smith, in a field survey on 10-27, 19 97, hereby certify that under requirements of P.A. 74, Michigan P.A. of 1970, the corner points mentioned lines 1 and 2 above were in conformance with regulations and rules therefore as required in the current manual of survey instructions of the United States Department of the Interior, Bureau of Land Management or by a decree of a Court of Law and/or that the corner points mentioned in lines 3, 4 and 5 above were in conformance with the rules of the Michigan Board of Professional Surveyors or by a Decree of a Court of Law; established, re-established, monumented, re-monumented, recovered, found as expressed below:

NOTE: Not more than 4 corners, all in the same town and range, may be recorded on this certificate.

A. Description of original monument and accessories and/or subsequent restoration:

M-12) 1837 GLO Quarter Section Post by John Brink, Deputy Surveyor; Beech 11 S35°W 35, Beech 10 N30°W 24
1909 D.E. Teed Survey Liber 1, Page 324. Set Midway between 2-3 found remains of Beech to Northwest, Lynn 16 S45°E 45, Hemlock 24 S71°W 19 1/2

B. Description of corner evidence found and/or method applied in restoring or reestablishing corner:

M-12) Set 5/8"x36" iron by single proportionate measure between the re-established Southeast corner section 36 and the found Southeast corner Section 13. This corner is accepted as a careful and faithful re-establishment of the position of the original corner being the quarter section corner common to Section 36, T23N, R12W, and Section 31, T23N, R11W.

C. Description of monument for corner and accessories established to perpetuate locating the position of the corner:

M-12) Set 5/8"x36" iron with Wexford County Brass Cap stamped E1/4 36, 1997, 39098 on side hill
S85°W 7.43' 16" Beech
N40°W 20.47' TW 8" Beech
N10°E 39.26' 14" Beech
N75°E 14.44' TW 8" Beech

Peer Group Reviewed and Approved
Date 30 oct 97
Richard D. Wilcox
Richard D. Wilcox, Wexford County Surveyor

STATE OF MICHIGAN
GEORGE D. SMITH
PROFESSIONAL SURVEYOR
39098
REGISTERED PROFESSIONAL SURVEYOR

Signed by George D. Smith Date 10-30-97
Surveyor's Michigan License No. 39098

FORM APPROVED BY MICHIGAN STATE BOARD OF PROFESSIONAL SURVEYORS, JAN. 28, 1971
REVISED MAY 14, 1975
REVISED JAN., 1983