

SURVEY & REMONUMENTATION

FEB 11 1998

SECTION

LAND CORNER RECORDATION CERTIFICATE Filing Requirement of Act 74, Mich. P.A. 1970

For corners in

Wexford	Located In:	Corner Code #
(County)		
1. Public Land Survey	T23NR 11W	C-13
	T___ R___	_____
	T___ R___	_____
	T___ R___	_____
2. Property Controlling in Section	S___ T___ R___	_____
	S___ T___ R___	_____
3. Miscellaneous Property in Sec.	S___ T___ R___	_____
	S___ T___ R___	_____

RECEIVED

1997 DEC 11 AM 9:32

Linda Loughmiller
WEXFORD COUNTY, MI
REGISTER OF DEEDS

Register of Deeds Stamp & File Number

4. Lot No. _____, Recorded Plat _____
5. Private Claims _____

I, George Smith, in a field survey on 8-21, 1997 do hereby state that under requirements of P.A. 74, Michigan P.A. of 1970, the corner points mentioned in lines 1 and 2 above were in conformance with regulations and rules therefore as required in the current manual of survey instructions of the United States Department of the Interior, Bureau of Land Management or by a decree of a Court of Law and /or that the corner points mentioned in lines 3, 4 and 5 above were in conformance with the rules of the Michigan Board of Land Surveyors or by a Decree of a Court of Law, established, re-established, monumented, recovered, found as expressed below:

NOTE: Not more than 2 corners, all in the same town and range, may be recorded on this certificate.

	A	B	C	D	E	F	G	H	I	J	K	L	M
1													
2		6		5		4		3		2		1	
3													
4		7		8		9		10		11		12	
5													
6		10		17		16		15		14		13	
7													
8		19		20		21		22		23		24	
9													
10		30		29		28		27		26		25	
11													
12		31		32		33		34		35		36	
13													

A. Description of original monument and accessories and/or subsequent restoration:

- C-13) 1837 GLO Section Post by John Brink, Deputy Surveyor; Beech 11 N82°E57, Hemlock 12 N29W°93
- 1848 GLO Subdivision of T22N-R11W by Orson Lyons, P.S.; Beech 5 S66½W26
- 1903 Survey by Devoe, Liber 1, Page 310, found original Government witnesses
- 1904 Survey by D.E. THEED, Liber 1, Page 208, found all 4 Government witnesses set trial pin for corner from each tree, dug and found rotten remains of old stake and identified ax marks on point of stake, set gas pipe ref. bk. 77, Page 68, 1 Hemlock 16" N¼°W 33½ links, Hemlock 24 N20°E 47L, Hemlock 30 S32°E 40L Hemlock 16" N30½W87
- 1966 Griffin RLS # 13584 LCRC, Liber 1, Page 469, found 1"x29" iron pipe on East slope of hill

B. Description of corner evidence found and/or method applied in restoring or reestablishing corner:

- (A continued) and found remains of 1 government witness, 12" Hemlock and 3 of Teeds witnesses, 16" Hemlock (stump), 30" Hemlock (stump), 24" Hemlock (stump). Position of iron pipe checks well with these witnesses. Set 2" pipe filled with concrete with 3" brass disk stamped T23N,R11W, S31, S32, S6, S5, T22N 1966 RLS 13584, 4" Maple N88°E 14.34', 7" Beech S22°E 41.94', TW Maple 10" and 7" S49°W 40.88', 6" Beech N36°W 2.97'
- 19?? WCRC witnesses - same as 1966 Griffin's LCRC


Found USFS mon. and all 4 witnesses as set by Griffin RLS #13584 in 1966 this corner is accepted as a careful and faithful perpetuation of the position of the original corner being the section corner common to Sections 31 and 32, T23N, R11W and Sections 6 and 5, T22N, R11W

C. Description of monument for corner and accessories established to perpetuate locating the position of the corner:

- USFS mon. with 3" brass disk
- N 88° E 14.34' 6" Maple (fd. nail)
- S 22° E 41.77' 10" Beech (fd. nail)
- S 49° W 40.34' TW 14" & 7" Beech (fd. nail)
- N 36° W 2.97' 10" Beech (fd. nail)

Peer Group Reviewed and Approved
Date: 30 Oct 97
Richard D. Wilcox
Richard D. Wilcox, Wexford County Surveyor

Signed by *George D. Smith*
Surveyor's Michigan License No. 39098

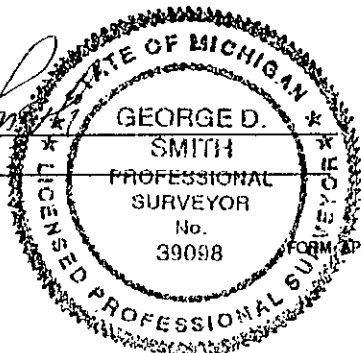

Date 10-30-97