

SURVEY & REMONUMENTATION

FEB 11 1998

LAND CORNER RECORDATION CERTIFICATE
Filing Requirement of Act 74, Mich. P.A. 1970

SECTION
For corners in

<u>Wexford</u> (County)	Located In:	Corner Code #
1. Public Land Survey	T23NR 11W	D-13
	T ___ R ___	_____
	T ___ R ___	_____
	T ___ R ___	_____
2. Property Controlling in Section	S ___ T ___ R ___	_____
	S ___ T ___ R ___	_____
3. Miscellaneous Property in Sec.	S ___ T ___ R ___	_____
	S ___ T ___ R ___	_____

4. Lot No. _____, Recorded Plat _____
5. Private Claims _____

I, George Smith, in a field survey on 8-21, 19 97 do hereby state that under requirements of P.A. 74, Michigan P.A. of 1970, the corner points mentioned in lines 1 and 2 above were in conformance with regulations and rules therefore as required in the current manual of survey instructions of the United States Department of the Interior, Bureau of Land Management or by a decree of a Court of Law and for that the corner points mentioned in lines 3, 4 and 5 above were in conformance with the rules of the Michigan Board of Land Surveyors or by a Decree of a Court of Law; established, re-established, monumented, recovered, found as expressed below:

NOTE: Not more than 2 corners, all in the same town and range, may be recorded on this certificate.

A. Description of original monument and accessories and/or subsequent restoration:

- D-13) 1837 GLO Quarter Section Post by John Brink, Deputy Surveyor; Sugar 8" N45°E, Sugar 7" N32½°W 5
- 1904 DE Teed Surveyer Liber 1, Page 208, set iron no witnesses given or monument found, dist. to Northwest corner Section 5, T22N, R11W, West 39.72 Chains dist. to Northeast corner, Section 5, T22N, R11W, East 39.76 Chains.
- 1966 Griffin RLS #13584 LCRC, Liber 1, Page 468, found 1¼"x18" iron pipe ±36.76 chains (roughly measured) West from Northeast corner of Section 5, T22N, R11W, replaced pipe with 2" iron filled with concrete with 3" brass disk, 1.5' above ground, stamped T23N, R11W, ¼ S32, S5, T22N, 1966 RLS #13584, 5" Maple N18°E 41.77', TW 5" Beech S64°W 75.79', 5" Ash S40°E 41.47', 6" Maple N6°W 37.86', 4"x7' Cedar Post North 1.7'

B. Description of corner evidence found and/or method applied in restoring or reestablishing corner:

A(cont.) 19?? WCRC witnesses same as 1966 Griffin LCRC

Found USFS monument and 4 witnesses as set by Griffin RLS #13584. This corner is accepted as the best available evidence of the position of the original corner being the quarter corner common to Section 32, T23N-R11W and Section 5, T22N-R11W.

C. Description of monument for corner and accessories established to perpetuate locating the position of the corner:


USFS monument with 3" brass disk stamped T23N, R11W ¼ S32, S5, T22N, 1966 RLS #13584
N18°E 41.85' 5" Maple, found nail
S64°W 75.85' 5" TW Beech, found nail
S40°E 41.57' 5" Ash, found nail
N06°W 37.94' 6" Maple, found nail

Peer Group Reviewed and Approved
Date: 10-30-97
Richard D. Wilcox
Richard D. Wilcox, Wexford County Surveyor

Signed by George D. Smith
Surveyor's Michigan License No. 39098



Date 10-30-97

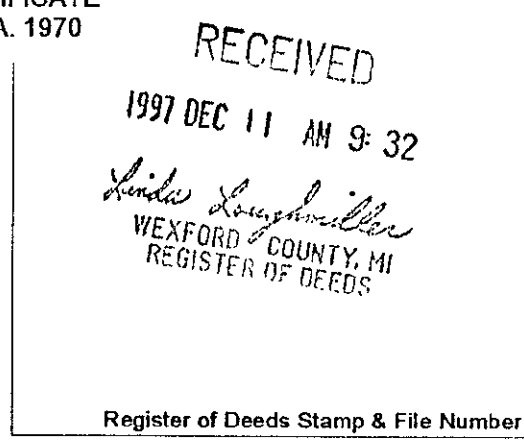

1	A	B	C	D	E	F	G	H	I	J	K	L
2		6		5		4		3		2		1
3												
4		7		8		9		10		11		12
5												
6		18		17		16		15		14		13
7												
8		19		20		21		22		23		24
9												
10		30		29		28		27		26		25
11												
12		31		32		33		34		35		36
13												