

# SURVEY & REMONUMENTATION

FEB 11 1998

## SECTION

For corners in

## LAND CORNER RECORDATION CERTIFICATE

Filing Requirement of Act 74, Mich. P.A. 1970

RECEIVED

1997 DEC 11 AM 9:32

*Linda Longmiller*  
WEXFORD COUNTY, MI  
REGISTER OF DEEDS

Register of Deeds Stamp & File Number

Wexford Located In: Corner Code #  
(County)

1. Public Land Survey T 23NR 11W E-13  
T \_\_\_ R \_\_\_  
T \_\_\_ R \_\_\_  
T \_\_\_ R \_\_\_

2. Property Controlling S \_\_\_ T \_\_\_ R \_\_\_  
in Section S \_\_\_ T \_\_\_ R \_\_\_

3. Miscellaneous S \_\_\_ T \_\_\_ R \_\_\_  
Property in Sec. S \_\_\_ T \_\_\_ R \_\_\_

4. Lot No. \_\_\_\_\_, Recorded Plat \_\_\_\_\_  
5. Private Claims \_\_\_\_\_

I, George Smith, in a field survey on 8-26, 19 97 do hereby state that under requirements of P.A. 74, Michigan P.A. of 1970, the corner points mentioned in lines 1 and 2 above were in conformance with regulations and rules therefore as required in the current manual of survey instructions of the United States Department of the Interior, Bureau of Land Management or by a decree of a Court of Law and /or that the corner points mentioned in lines 3, 4 and 5 above were in conformance with the rules of the Michigan Board of Land Surveyors or by a Decree of a Court of Law; established, re-established, monumented, recovered, found as expressed below:

NOTE: Not more than 2 corners, all in the same town and range, may be recorded on this certificate.

	A	B	C	D	E	F	G	H	I	J	K	L	M
1													
2		6		5		4		3		2		1	
3													
4		7		8		9		10		11		12	
5													
6		18		17		16		15		14		13	
7													
8		19		20		21		22		23		24	
9													
10		30		29		28		27		26		25	
11													
12		31		32		33		34		35		36	
13													

A. Description of original monument and accessories and/or subsequent restoration:

- E-13) 1837 GLO Section Post by John Brink, Deputy Surveyor; Beech 12" N83°E 35, Beech 14" N62½°W 44L
- 1848 GLO Subdivision, T22N-R11W by Orson Lyons, Deputy Surveyor; Beech 6 S24½°W 16, Beech 12 S25°E 16
- 1904 D.E. TEED Survey, Liber 1, Page 208, Book 77, Page 68 by pulling witnesses from remains of GLO witnesses, found 8" of black mole in shape of stake 1' below surface put in gas pipe 14" below surface with cherry stake on top. Fire cherry 8 S29°W 41½, Apple 6 S43½°E 49½ Item 12 S 64½°W 104', Sugar 18 S82½°W 155
- 1966 Griffin RLS #13584 LCRC, Liber 1, Page 467, found 1¼" x 24" pipe 18" below surface and 2 of Teeds Witnesses 6" Apple (stump) 8" cherry removed, found pipe with 5" x 3' conc. post

B. Description of corner evidence found and/or method applied in restoring or reestablishing corner:

(A continued) with 3" brass disk stamped: T23N-R11W, S32, S33, S5, S4, T22N, 1966, RLS #13584 7" Beech N53°E 46.52', 7" Maple S42°E 69.06' Center of cherry 21" (Teed's witness) S29°W 27.63 (41.861 links) 6" Maple N10°W 49.65' 5" x 7' cedar post North 33'

19?? W.C.R.C. witnesses same as 1966 Griffin LCRC

B.) Found USFS monument with 3" brass disk and 1 of Griffins witnesses. This corner is accepted as a careful and faithful perpetuation of the original corner, being the Section corner common to Sections 32 and 33, T23N-R11W and Sections 4 and 5, T22N-R11W.


C. Description of monument for corner and accessories established to perpetuate locating the position of the corner:

USFS monument with 3" brass disk, 12' S'ly of centerline trail East-West and in centerline trail S'ly  
S76°E 46.67 feet 18" Cherry, set nail  
S63°W 6.59 feet 14" Ash, set nail  
N08°E 24.78 feet 4" Maple, set nail  
N55°E 46.57 feet 16" Beech, set nail

Peer Group Reviewed and Approved

Date: 30 Oct 97  
*Richard D. Wilcox*  
Richard D. Wilcox, Wexford County Surveyor

Signed by *George Smith*  
Surveyor's Michigan License No. 39068

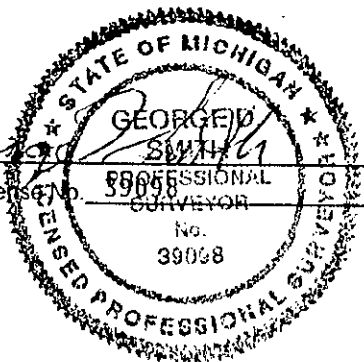

Date 10-30-97