

**SURVEY & REMONUMENTATION**

**FEB 11 1998**

**SECTION**

**LAND CORNER RECORDATION CERTIFICATE**  
Filing Requirement of Act 74, Mich. P.A. 1970

For corners in

|                                    |                |               |
|------------------------------------|----------------|---------------|
| <u>Wexford</u><br>(County)         | Located In:    | Corner Code # |
| 1. Public Land Survey              | T23NR 11W      | F-13          |
|                                    | T___ R___      | _____         |
|                                    | T___ R___      | _____         |
|                                    | T___ R___      | _____         |
| 2. Property Controlling in Section | S___ T___ R___ | _____         |
|                                    | S___ T___ R___ | _____         |
| 3. Miscellaneous Property in Sec.  | S___ T___ R___ | _____         |
|                                    | S___ T___ R___ | _____         |

**RECEIVED**  
1997 DEC 11 AM 9:32  
*Linda Langhammer*  
WEXFORD COUNTY, MI  
REGISTER OF DEEDS

Register of Deeds Stamp & File Number

4. Lot No. \_\_\_\_\_, Recorded Plat \_\_\_\_\_  
5. Private Claims \_\_\_\_\_

I, George D. Smith, in a field survey on 9-25, 1997 do hereby state that under requirements of P.A. 74, Michigan P.A. of 1970, the corner points mentioned in lines 1 and 2 above were in conformance with regulations and rules therefore as required in the current manual of survey instructions of the United States Department of the Interior, Bureau of Land Management or by a decree of a Court of Law and /or that the corner points mentioned in lines 3, 4 and 5 above were in conformance with the rules of the Michigan Board of Land Surveyors or by a Decree of a Court of Law; established, re-established, monumented, recovered, found as expressed below:

| A  | B  | C | D  | E | F  | G | H  | I | J  | K | L  | M |
|----|----|---|----|---|----|---|----|---|----|---|----|---|
| 1  |    |   |    |   |    |   |    |   |    |   |    |   |
| 2  | 6  |   | 5  |   | 4  |   | 3  |   | 2  |   | 1  |   |
| 3  |    |   |    |   |    |   |    |   |    |   |    |   |
| 4  | 7  |   | 8  |   | 9  |   | 10 |   | 11 |   | 12 |   |
| 5  |    |   |    |   |    |   |    |   |    |   |    |   |
| 6  | 18 |   | 17 |   | 16 |   | 15 |   | 14 |   | 13 |   |
| 7  |    |   |    |   |    |   |    |   |    |   |    |   |
| 8  | 19 |   | 20 |   | 21 |   | 22 |   | 23 |   | 24 |   |
| 9  |    |   |    |   |    |   |    |   |    |   |    |   |
| 10 | 30 |   | 29 |   | 28 |   | 27 |   | 26 |   | 25 |   |
| 11 |    |   |    |   |    |   |    |   |    |   |    |   |
| 12 | 31 |   | 32 |   | 33 |   | 34 |   | 35 |   | 36 |   |
| 13 |    |   |    |   |    |   |    |   |    |   |    |   |

**NOTE:** Not more than 2 corners, all in the same town and range, may be recorded on this certificate.

A. Description of original monument and accessories and/or subsequent restoration:

F-13) 1837 GLO 1/4 Section Post by John Brink, Deputy Surveyor; Sugar 9, N74°E 15, Sugar 11, N33°W 21

B. Description of corner evidence found and/or method applied in restoring or reestablishing corner:

Re-established corner by single proportionate measure between found corners 1/2 mile to East and 1/2 mile West. Corner falls ± 20' North of centerline 2-track. This corner is accepted as a careful and faithful re-establishment of the position of the original corner being the 1/4 corner common to Section 34, T23N-R11W and Section 4, T22N-R11W.


C. Description of monument for corner and accessories established to perpetuate locating the position of the corner:

Set 5/8" x 36" iron with Wexford County brass cap, stamped: S 1/4 33, 1997, 39098 ± 20' North of centerline 2-track

- 14" Cherry 35.75' S 02°E
- 8" Tw. Basswood 4.73' N 25°E
- 8" Beech 9.03' S45°W
- 6" Tw. Beech 15.91' N 35°W

Peer Group Reviewed and Approved  
Date: 30 Oct 97  
*Richard D. Wilcox*  
Richard D. Wilcox, Wexford County Surveyor

Signed by *George D. Smith*  
Surveyor's Michigan License No. 39098

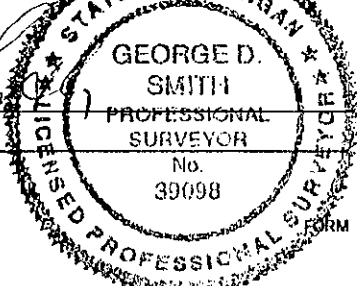

Date 10-30-97